#623309

1

1/4 corner center 33 Eyota 10 6-12.
8-1856 Hunter P16 No 25 L½-L33.
used or set corner -
- meas east 39.85 2630.1 N 89½ E
- 1/16 west 20.07 M & L 132462. "
- 1/16 south 19.92 M & L 131472 N 1°10' W
- 1/16 center SW¼ 33 19.92 N to 1/16 N 1¼° W.
19.96 W to 1/16 N 89¾° E.
- 1/16 center SE¼ 33 19.96 W to 1/16. N 89°25' E
19.96 S to 1/16 N 1°5' W.

8-5-68 JKerr meas line from nail in line center roads east and south at 1/4 33-34 - set nail in line fence north and south. 2638. Hunter record 2630. ones.

from center 33 fences west to 1/16 fence north 1325.2

Hunters record. 1324.6


from center 33 fences west to nail in center north-south road

Brass 2626 record 2649.2

from center 33 fences east to 1/16 fence south 1322 record 1315'


from center 33 fences east to 1/16 fence north 1317 " "

from 1/16 fence east of center 33 which runs north to nail east 1321 record 1315

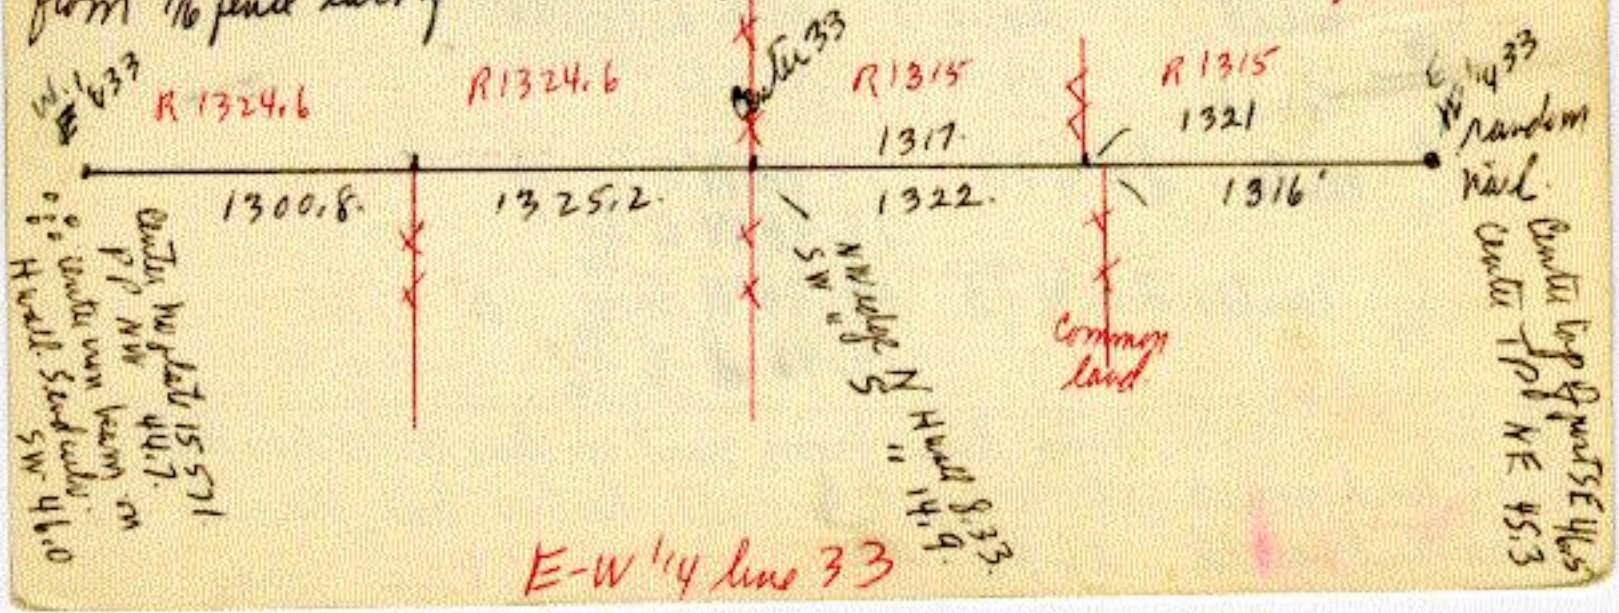

E-W 1/4 line 33

#623309 (2)

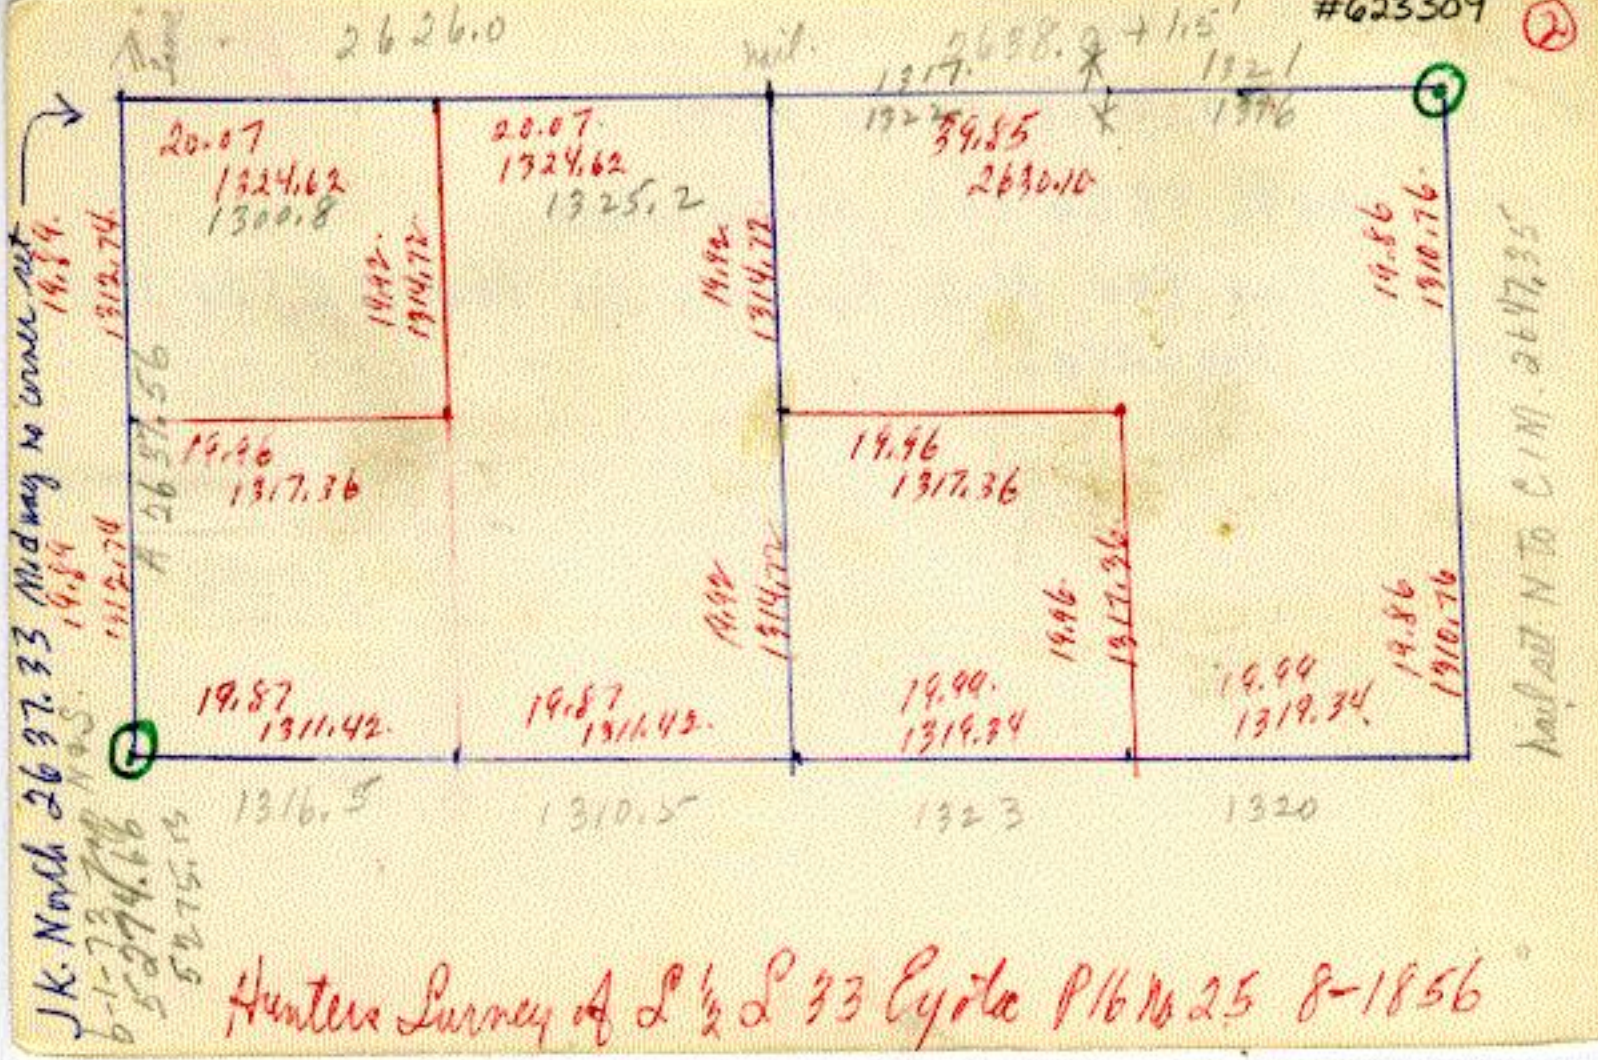
20.07
1324.62
1300.8
20.07
1324.62
1325.2
19.96
1317.36
19.96
1317.36
19.87
1311.42
19.87
1311.42
19.99
1319.34
19.99
1319.34
1316.5
1310.5
1323
1320
Hunters Survey A S ½ S 33 Cycle P/L No 25 8-1856

may, 1856 Thos. Hunter Page 6 No. 9 Shows Center Sec.
1/16 East 19.92½M&L to 1/4 Post
Meas North 39.86 Chs. to 1/4 Post.
T. Hunter Ran the N-S 1/16 line in the N.E. 1/4 but
gives no measure.