1 6-5-1973 set C/M over brass & tack. ①
c-1 3-11-75
Section Corner south 33-34 Eyota 106-12 #623405
north 3-4 Orion 105-12.

8-1856 Hunter P16 no 25 d-d½33.

used corner.

1/16 north 19.86 1310.76 M & d. N 1°40 W.
1/16 west 19.99 1319.34 M & d. N 89½°E
1/16 center d E¼ 33 19.96 1317.36 + N 1°05' W of 1/16 cor.

S 39°W 101 lks (check) — S 55½°E 108 lks (check)

8-2-1968 J Kerr
meas from south 32-33 - 5270 to nail in line center roads north and west - RP nail 61.85 to power pole with mile attached 61.3 to power pole with yard light. Hunter 5261.5 over.

8-5-68 meas line from CIM NE33 - 5275.35

Hunters record 5251.6

1/16 north 1329.85 to corner past of former fence west


Hunt Record 1310.76

- meas north to nail in line & roads east & west 2643.35

Hunters record 2621.52

— meas of north half- nail at E1/4 33 to NE33 2632.0

Hunter - 2630.1

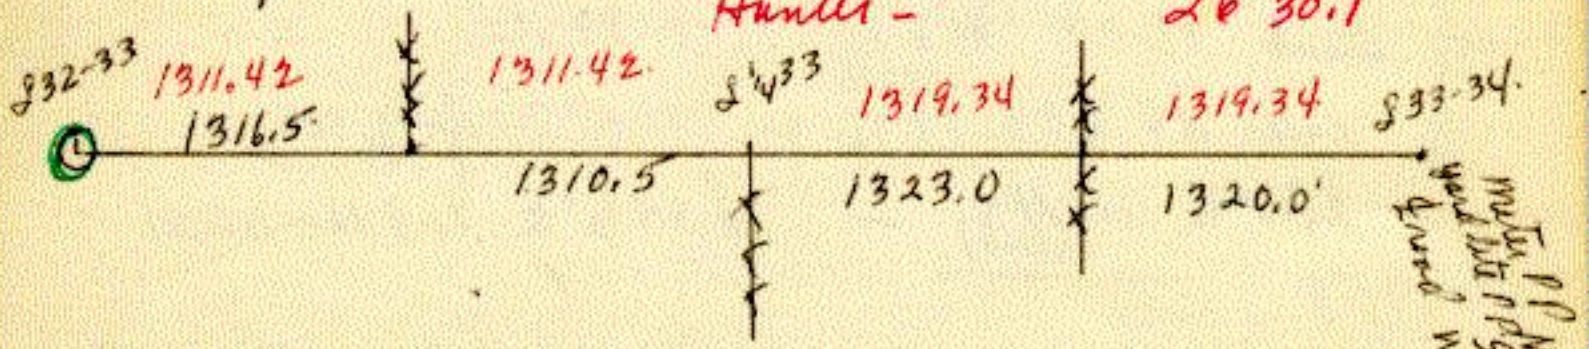

South line 33

#623405 (2)

Card #2. south 33-34 Eyota 106-12.
north 3-4 Orion 105-12.

6-4-73 found nail driven on meas from S 32-33
on 8-1968 from Power pole R P.S. 5270 E of S 32-33.
- projected line and meas east electronic from S 32-33 over
nail on line fence southard in center road at S¼ 33.
this fell. 14.65 south of 1968 nail (no line then).
6-5 set S¼ 33 11.38 north of nail at S¼ 33 (Lee corner)
so direct line would be. 22.76 north of nail set at S 33-34.
- meas S 32-33 to C I N set at S¼ 33 2626.20 R. 2622.84
dug entire area to clay in farm driveway. or yardway and
found likely "black dirt hole 4" dia" about 33' from.
row of maples west and possible stump depression in
yard 33' north. accepted this as corner until proven

otherwise - set RR spike and piece of limestone and glass with C1M above. thus fell. 14.0' North 3.44 West of 1968 nail. some 2639.8 east of C1M set at S¼33 and 14.65 + 14.0 or 28.65 North of E-West line had first run or. 28.65 - 22.76 or 5.89 north of final line from S 32-33 C1M over S¼ 33 C1M 1968 5270 - 3.44.
Total Mile 5266.0 H 1856 5261.5 (5266.56
no final mear to stone and C1M at ¼ 33-34. 2626 ±
61.3 N to eye line & edge house west of road.
56.1 W to " E " " " "
52.7 NW to center power pole with meter
39.9 NE to Conc nail in knot on NW side tele pole up 4'

April, 1863 P.C. Compton Pg 68 No 96 shows Sec. Cor.
(see survey for breakdown of Sec. 34

#623405 3

Section corner south 33-34 Eyota 106-12
north 3-4 Orion 105-12

Gov. notes 1853 Oct. Ball, Dep. Sur.
West between 3 and 34.
80.00 Set post and drove charred stake.

623405 F

12-10-98
EPA JPJ
93

√S SEC COR 33-34 | 106-12 EYOTA
N SEC COR 3-4 | 105-12 ORION
FOUND CIM IN GOOD CONDITION DOWN 1.4'
CORNER FALLS 4' W ℄ TWP ROAD NORTH
18' N OF ℄ CROOKED TWP ROAD WEST
24' SE OF ℄ OF CURVED ROAD
33.1' NNW OF GPS PT "HANSON"
CENTER OF PP NE 30'