12-1980 CIM gone in bridgework — only 1 Tie Left (1)
10-12-63 set CIM over iron rod #630105
6-16-87 - Set CIM
section corner 4-2-11-12 Marion 106-13.
12-1910 Ch Larson P 142 B 12 Rubow, Trapp & others
set iron rod as corner - no desc or explanation.
- south shows meas of 696' to RR tracks.

1951 JKerr B52 P57 found iron stake, meas west 2618.25

1962 JKerr B85 P45 - found iron meas east 2639.2 M&L

1964 JKerr B89 P69 used CIM. meas east 2639.2 Could be different now. RD.

meas south 2630.5 with 1/16 cor set M&L

Note: T. Hunter's Plat of Chester" July 1873 - could have used This Corner To Layout Plat. Does not describe Corner used.
See Also T.H. field BK 3 P.49-50 for field notes of Plat.

1885 T.H. BK 14, P41 Measure West 39.58 to 1/4 Cor 2-11 and So 10.47 to cor used old fence post and possibly Ave tree NE (other)

10-1963 set C/M as corner, bridge widened which upset R.Ps caused lot of digging over 3' deep to find rod

West angle corner of south bridge rail.		12-1980 L/C. reported - gone	SE	20.42
" " " " north " "		gone	NE	25.6
disc	in tele pole.	gone	NE	87.2
disc	in tele pole	gone	NW	102.16
spud.	in power pole. — Pole still here —		SW	53.24
disc	in 10" oak corner post in line fence -		N	30.43

Govt Notes 1853 Wm. Jones

30.00 Sts pass to corner to station 1-2-11-12


Bu-Oak	15	N 80½	E 505
" "	6	N 15	W 869
" "	5	S 2	W 360
" "	13	S 84	E 900

#630105 (2)

Section Corner 1-2-11-12, Marion, 106-13

6-24-82, 1/16 North: Found ½" rod in clump of large willows. Shot corner. The main line of the fence East would fall 15' to 20' North. The fence West is fairly new and lines with corner fairly well although there are several wood posts standing 15' to 18' North of the newer fence.

6-24-82, Property corner 321.0 North: Found pipe and cap standing in line with the fence North and 8'± East of the fence South

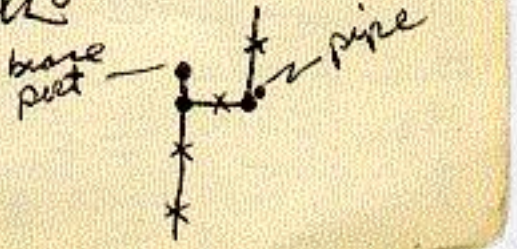

6-30-82, Sec. Cor. 1-2-11-12 & T. Hunter (Old Fieldbook 14, Page 41) used a point here as the corner in line with the fence North and 2' rocks South and measured 39.58 ch (2612.28) to 1/4 Cor 2-11. Our measure (2619.36) indicates this fence should be 7'+ West of the present corner and at the McGhie prop. corner 321.0 North the old fence is 7.7 West. We dug for Hunter's fence (N. of road) and found old barbed wire and even an old steel fence post (angle iron with hole drilled for wire). Some wire 2' deep. However, there were so many tree stumps, tree roots, etc., we could not cover much area and could not find any wood fence posts. The wire found was from 8' to 10' West of the CIM. There is a new fence running North and the corner post for this fence is appx. 14' East of the CIM. When I can't set the CIM, he tied to a corner post. North of the monument. We also went South and found the remains of the fence 150' to 300' South and projected this up and fell in the area of the present CIM.

#630105 (3)

Section Corner 1-2-11-12, Marion, 106-13

7-14-82, Sec. Cor 1-2-11-12: Dug from Kerr's (.I.M (down 12") West for 8'+. Found a 5/8"x15" re-rod down 6" 1.32 South and .62 West. This rod fit Connie's ties to the bridge rail NE and SE. The CIM was set over a 3/4"x30" re-rod (3.3 deep and driven in the next road) and ~~driven~~ a 1"x14" pointed iron down 4½'. We dug to 10' deep and it was still 1' to any natural soil so we did not get a look at the bottom. Did not find anything further beneath the CIM. There was a 3rd rd. 6'± deep.

4.12 E
3.94 S

CIM { 5.92 E / 5.92 S

Connie 5/8" rod { ENE 6.73 / SSE 4.83

1" iron { 5.85 E / 5.76 S

.07 E
.16 S

6-1985 Stopped at corner. New culverts in place of bridge. Could get no dip at all

6/16/87 COR 1-2-11-12 MARION SET CIM OVER ½" RE-ROD AT LOCATION OF IRON FD 4½' DEEP ON CORNER. 16 SO. & 07 E. OF KERR'S CIM REMOVED CORNER 4' SO. OF ℄ E-W RD. AT CORNER BUT IN LINE & FARTHER EAST CORNER 27½' W OF CENTER N-S CREEK, CORNER 2' E OF NEWER FENCE RUNNING NORTH RP's

SPUD NW SIDE PP # 21416 SW 53.33

CSD IN TOP OF C.P. N14 34.52