/ 4-29-82 CIC/p2

#630206

1/4 corner 2-3 Marion 106-13


10-1882 Hunter P380 No 371 L3 JPFelps, E Cross

found stone planted as 1/4 corner with part of orig stake by stone and remainder lying on ground nearby.
- Meas south 40.03 (2642.0
- West set property stake 11 chains on E-W 1/4 line.
-- also set property stake 11 chains east of center sec 3 on E-W 1/4 line. Center 3 a marked stake altho no records of such sub-division on record.

June, 1857 John B. Fellows Pg. 26 No. 42 used 1/4 Corner Meas East 40 chs. meas. North 39.90 chs.

Gov't Note Wm. Jones 1853
57.85 S-E post of quarter section post
depressed chamfered mark wood cross
pits planted stony soil N.E. & S.W.

4-28-82, 1/4 Cor 2-3: Dug from the c.p. North 4' and West 3'. Found a 1½" x 9" x 15" limestone standing with edges East and West but no stake.

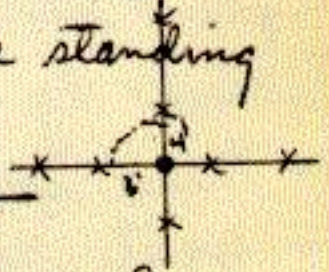

4-28-82, 11:00 chs. West of 1/4 Cor 2-3: Chained 726' West from the stone found at 1/4 Cor 2-3. Dug from this point in the E-W fence, West 2', East 1', and North ?½'. Found nothing.

4-29-82, 1/4 Cor 2-3: Drove a telepar pipe with Cast Iron Cap at the location of the stone found 4-28-82. Dug the stone in on the E side. This corner 2½' West and 1½' North of main c.p. to fence N-S-E-W (survey marks sign on post)
RP: CSD in SE side brace post WSW 6.75
CSD in NE side c.p. SE 2.76