9-21-1963 set C/M over RR spike in bed rock. in place orig stone.
8-5-1969 reset after grading road gone to spike, cut into bed rock enough to set short C/M nothing below. #632304

1/4 corner 23-26 Marion 106-13

6-1877 Hunter P 348 no 312 S 25 James Campion found orig govt stake standing with stamps & both BT's tested by govt field notes and found correct set stone 2x10x14 with old stake by its side. - Meas east 40.00 to Cor found.


5-1884. Hunter P 389 no 38 S 23 A Anderson & others.
found stone set P 348.
-16 west set stone M & L 20.00 (Meas N 39.92½ 2635.05'
-16 east set stone M & L 20.00 (Meas N 19.94¾ M&L 1316.54.
- north set stake at 29.94 (1976.0 then 9.98 to Center S 23. (658.68)

5-1940 B20 P34 J Kerr. S 26 and 27 J O'Neill:
show meas of 2637.25 east - 2636.6 west

6-1951 B51 P68 J Kerr S 26. Lenard Leitzen.
Meas east & west same as B20 found. limestone set 3"
cast pipe on top - corner 1.2' south of direct line.
- Meas south 2630.18 with bridge bolt set 1315.69 N of
Center 26. also bridge bolt set on the NW 1/4 M & L on E-W 1/16
line 1317.95' which lies 1315.62 north of 1/16 west of Center 26.

1963 C I M set over railroad spike driven in bed rock. corner
removed for grading 6-1968 & referenced to tree - on resetting 8-5-69
found road surface all taken off - rail spike just below surface.
broke out rock and set short C I M nothing below.
RP to corner on Card # 2.

Card # 2. 1/4 corner · 23-26. #632304

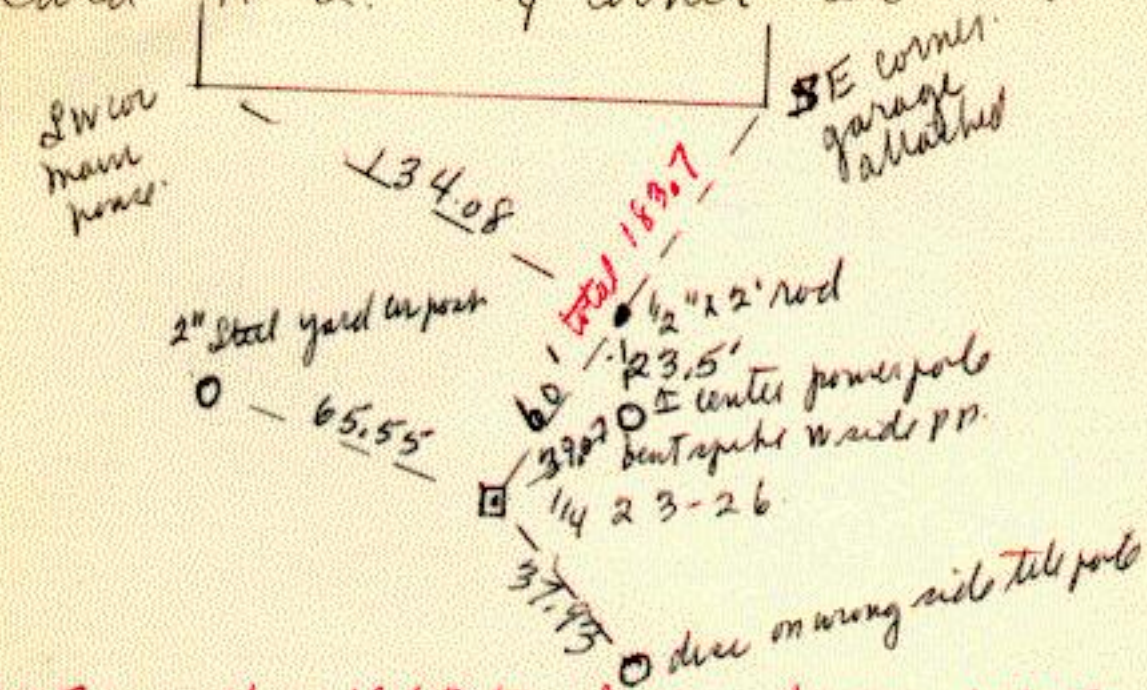

183,7 orig tie 1963 to SE cor house NNE
assum NE corner garage to be same.
Corner lies in center road - no N-S fences.

Cor Nom, W. Surv, 1853

39.93 Sec post of grave mk. ---

B. Oak 10 N 61 E 302

B. Oak 12 S 65 W 141