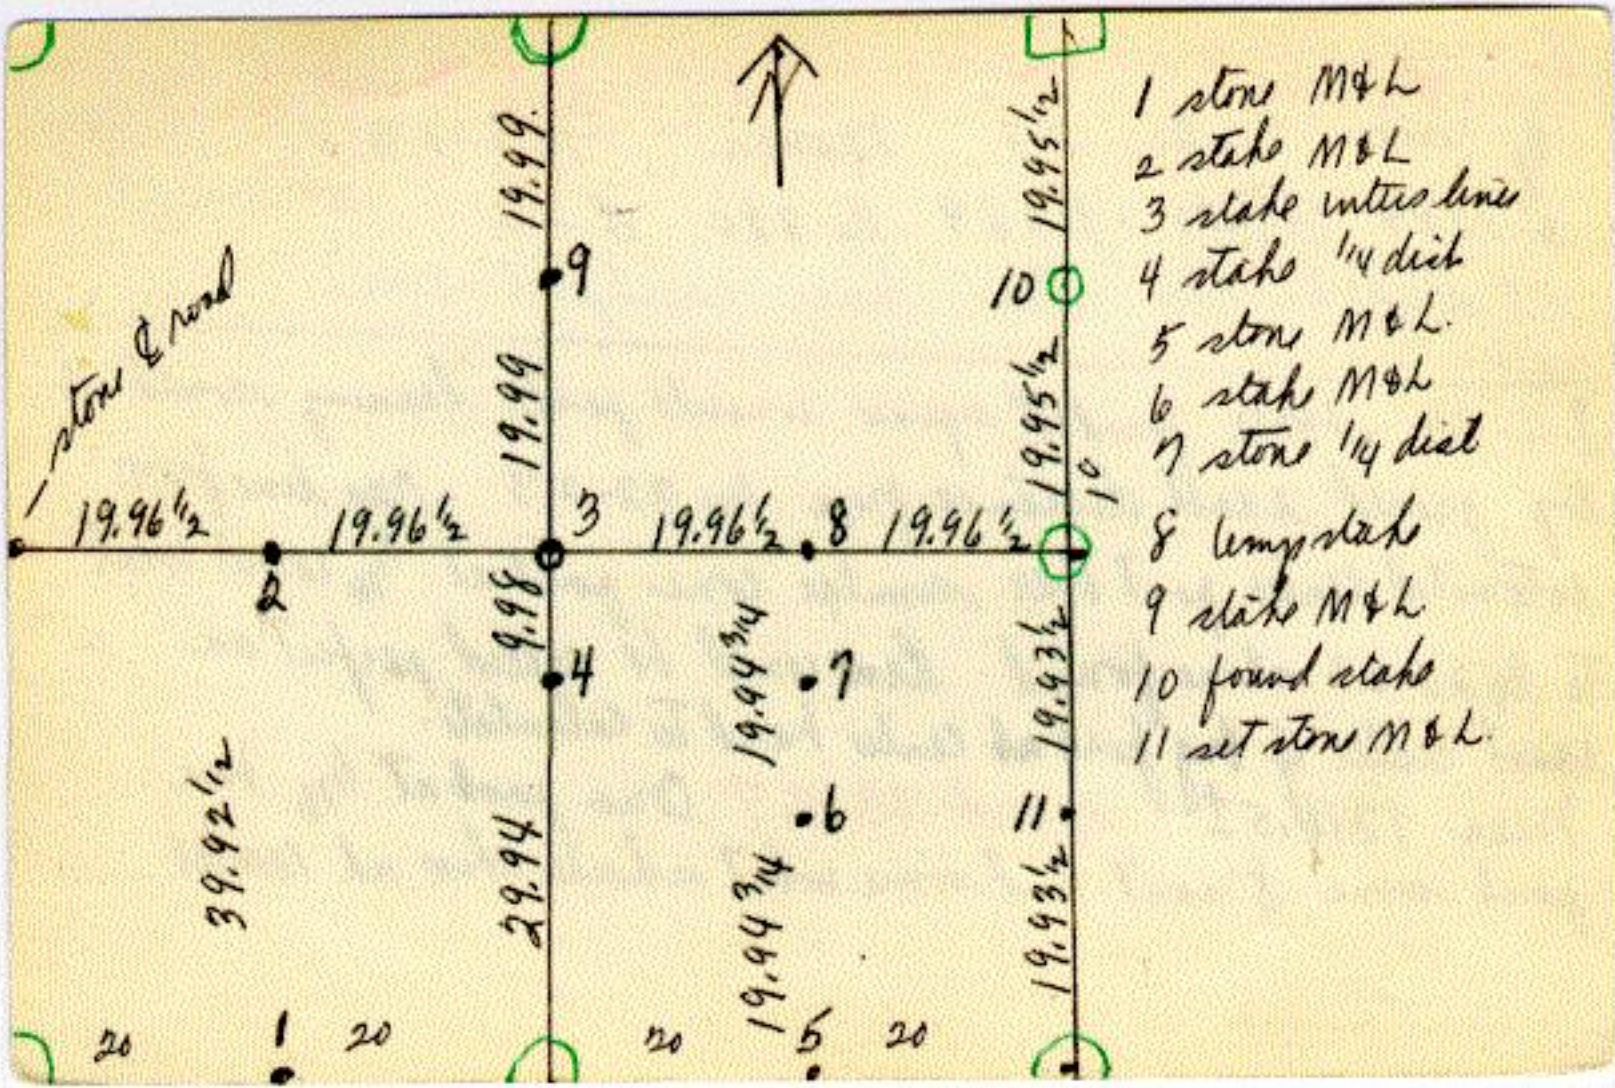
8-15-69 12" square concrete post in place proved exact location.
1/4 corner Center 23 Marion 106-13 (1)
5-1884 Hunter P389 No 380 ∠ 23 #632309
set stake at true miter lines. (see plat-over)

8-16-69 J Kerr found 12" square concrete post leaning south at top, proved exact distance from 1/4 22-23. - run line from estimated center post over similar cone post at 1/16 corner west to 1/4 22-23 stone found. Line could be called perfect as exact center of big post at center hard to calculate.
Meas 1318.5± record 1317.7 Cone post at 1/16 has post some 8' east and somewhat shorter than at center.


1 stone M&L
2 stake M&L
3 stake intersection
4 stake 1/4 dist
5 stone M&L
6 stake M&L
7 stone 1/4 dist
8 temp stake
9 stake M&L
10 found stake
11 set stone M&L
stone & mound
19.96½
19.96½
19.96½
19.96½
19.99
19.99
19.98
19.94¾
19.94¾
19.95½
19.95½
19.93½
19.93½
39.92½
29.94
20
20
20
20

#632309

(2)

1/4 corner. Center 23 Marion 106-13
5-1884 Hunter P389 No 380 S23 Anderson & Lockers.
set stake at true inters lines
-16 north set stake M & L. 19.99 (1319.34'
-16 west set stake M & L. 19.96½ (1317.8'
-16 east set temp stake M & L. 19.96½ (1317.8' all commonland.
-16 south stake as 1/64 cor 9.98 (658.68' then 29.94 (1976.0' to S 1/4 cor.

8-16-69 J Kerr B101 P38. obs 12" square concrete 6' high as corner post leaning south 18" or better. Meas from Center base, took line from where center base might have been if erect. - found similar post quite straight and less above ground. with similar one east of line as brace. at 1316.5 west 4post at Cent 23 (OVER)

to find W 1/4 23 used center of these 12" □ cone posts as line and meas 1316.5 projected and doubled across open field to road west 1316.5 found stone

east .45 and north 1.3' of line meas & projected in which indicates large post at center leaning south could have pushed south from extreme bottom likely 3 or 4' below ground. The east west likely very close - stoned run aerial between stone at W 1/4 and county drill steel as E 1/4 this would prove one or the other. If 1/16 post right center stoned be south of leaning post etc.