X

641909


1/4 corner. center 19. Rock 106-14.
6-1889 Thos Fraser P433 No 420 B Clark & others
Corner in dispute some 2 or 3 feet as to location
of existing fence corner, as usual left as is.

C H Mayo.

4-1923 J Kerr P390 B L19.
set stone at intersc lines
- meas east 2653 to stone set on W Frasers stake.
- meas west 2566 to stone
- 16 north set stone M & L 1319.7
- 16 center NW 1/4 19 set stone - meas N 1320.27, E 1326.4
- 16 center NE 1/4 19 set stone M & L 1328.25 on E-W 1/16 line (ones)

Meas south 2636.6. to stone set from NW B tree.

Nov, 1857 T. Hunter Pg. 39 No. 61 shows Center Sec.
Meas. west 38.92 chs. to 1/4 Post.
Meas. East 40.00 chs. to 1/4 Post.
1/16 North 19.89 chs. M&L to 1/4 Post.
(See Survey for breakdown of N.E. 1/4 Sec. 19).

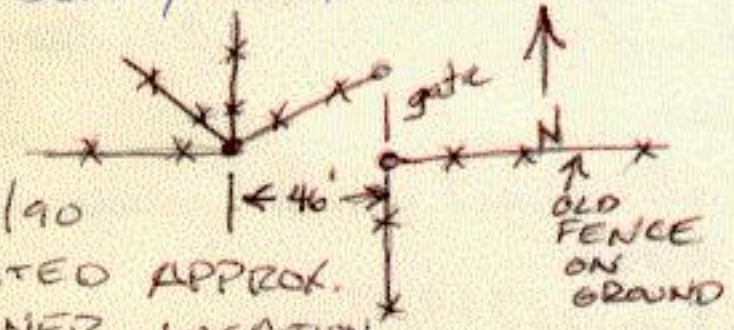

2/5/90
VISITED APPROX. CORNER LOCATION
FENCES ALL DIRECTIONS