/ 5-1982 dog with backhoe but did not find anything
1990 McGhie; BcHS set 5/8" PIPE/CAP #642509 card #1

1/4 Corner Center 25 Rock 106-14

7-1857 Hunter P35 No 56 - SE 1/4 25 106-14.
SW 1/4 30, NW 1/4 31 106-13

used or set corner.


- Meas south	39.92.	N 3' E	2634.72
-16 east M & L	19.83	N 89 3/4 W 1308.78	2617.56
-16 center SE 25	-	19.96 N - 19.81 E	

Co H D 10-1945 B 149 P45

ran E-W 1/4 line 5252.0 set corner in line fence at Center 25
Sp in Cor F.P. S 27.0 Sp F.P. SE 34.13
fence at 2627. from W 1/4 25 M & L would be 1' west of fence S.

elaborate ties (OVER)

Co. H.D. B. 149 P. 45

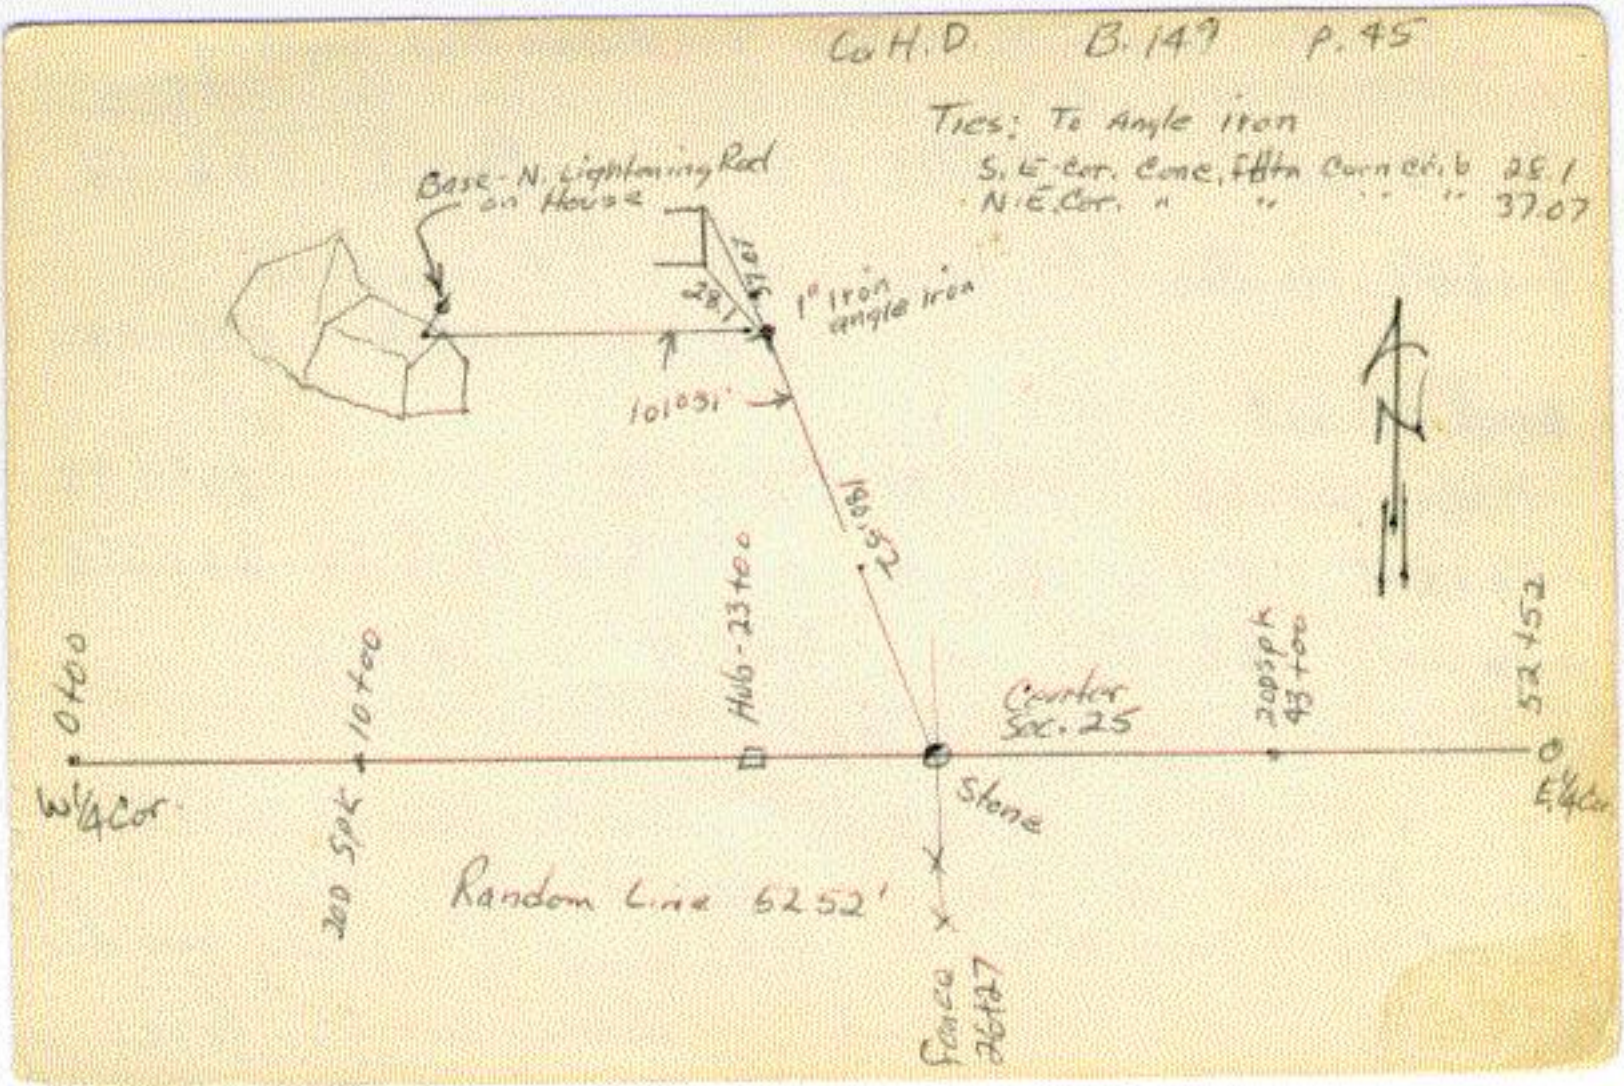

#642509 Card #2

Center 25, Rochester, 106-14

5-17-82, Center 25: Dug from a point 4½ North of the t.n. set in the center of the E-W road and in line with the fence South, North for 5', East 2', West 5' by 3½' deep to clay. No old roads present. Found absolutely nothing.



2/12/90 Fd 5/8" pipe set by McGhee, Betts
Rp's 7.0' south to ℄ of gravel rd.
1.5' east to line of fence south