6-15-1964. set C/M over 3/4" x 1" rod. (1)

section Corner 27-28-33-34 Roch 106-14

(#642705

5-1875 Hunter P 274 no 272 S 27-34 J.M. Talbert.

found Mound & trench with stakes in mound and.

NW B tree standing 16" burr oak N 44 1/2° W 38 links.

also stump N.E. B tree. (no desc. of corner set).

-16 east set temp stake M & L 19.88 1/4.

-16 south " " " " 19.98

-16 north " stake " 19.98 3/4.

1882 Caplton - 16 centr NW 1/4 34 found fence corner correct

as corner intersines. See T.H. Bk 5 p.88 Sec 28

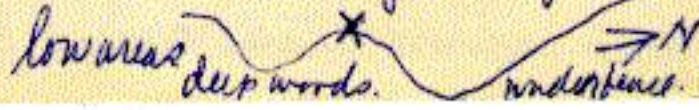
6-1903 Ch Armstrong P 64 B S 27 part of 34. Talbert.

was shown stake agreed by Mr Richards as corner. J. Carr.

ones.

but could not identify NW B line so ran line east to LE 27. then found Hunters stake at 1/16 west of LE 27. on re-running line west found true corner 160 lks north and then found B tree recently cut still marked P 274.
- set limestone 2 x 12 x 15 with B bees as follows.
9" Burroak S 40° W 45 lks 29.7 — 8" Beak NE 26½ lks 17.5'
- meas east 79.60 all in open land but 1/16 mentioned which lay 6" south of straight line.

1958 found stone with cross. meas west 2661.95 M & L.
1960 " " meas north 1317.87 to M & L.
6-1964. set CIM over 3/4 x 1" rod. steel putman & stones as witness.
9" blazed B O. from blaze SSE 8.9 10" blazed cherry tree SW 12.7
12" " " " " NE 3.8
14" " " " " NW 17.1
8" burroak. center S 27.0
16" " " " S 34.0

Corner in high ridge between low areas from blaze


Card # 2. 27-28-33-34. Rochester 106-14 (2)
found C/M. in very weedy, brushy area. land all go back
and unused. corner under fence easy to see once close
- corner on top of high area between 2 natural draws
draw north deeper than south draw. #642705
- set up traverse from corner NE by to open area
then direct to. 26-27-34-35 by electronic 5245.64 ~~5246.98~~
J Kerr computed meas in early '60 survey 5247.75
by angle & meas of E-W 1/16 line on road north likely.

Govt Notes W.B. Yaby 1854
$0.00 Set a post to Set C7, 28, 33 + 34
Bur Oak 12 N 48 W 46 lks
Aspen 12 N 23 E 94 lks