#643506

7-11-1961 set C I M over iron and boulders. (1)
7-17-1974 reset "shorty" C.I.M. over original C.I.M.
1/4 Corner 34-35 Rock 10 6-14
5-1875 Hunter P 274 No 272 & 27-35 J M Talbert found orig stake standing stated stumps of B bros. drove stake well down in center road and set boulder stones on east & west side.
-16 west set boulder with stake on east side M & L. 19.91. (314.06' to stake set at center. (1882 Caption.

---

4-1890 Thos Fraser P 438 No 425 & 26 Baker Feeney found stake with 3 small boulders arround it. Convey owned by Mr Carr as corner Hunter used. P 274.
- used to set S E cor 27. - Meas to S E 27 40.02 1/2
6-1903 Ch Armstrong P 64 B found stake & stones - meas N 6 39.97.

7-1961. J Kerr. dug & found stake & stones in center road. , in line fence east, no fence west. set C/M. over iron bar in boulders. Book 80 P 69
- center corner fence post of fence east. E 27.4
- Spike in brace fence post E 39.15
-16 west found boulder P 274. & stake - set 1/2" rod in place of stake. at 1314.2 also found stake hole at center 34 on line & double mine.
-16 south set ~~rod~~ small pipe in road M & L. (see 8-8-72) R.P. rod under fence east. 50' then anothe 50 on transit line to another 1/2" rod. about 1'+ north of fence.

#6435060

Card # 2 1/4 34-35 Rochelle 106-14. (2)

8-7-72 found iron rise over C/M as E Reference did not check removed rise found C/M 11" deep.

39.34 E to org spud in fence post org 39.15

22.51 due E to punch hole in S end 18" field drive Cule B79 P47

33.72 NE same N end cule JK 2639.12

Zaped direct to C/M at 26-27-34-35. 2638.11

Zaped direct to 1/16 S set by J Keel. 1317.92.

Zap direct 1/16 S to C/M at S34-35 1318.11

Locate C/M again July 16, 1974 ± 12" deep set shorty over it

(1/16 S. over)

8-7-72 found nail set by Kasseler also 120 D nail badly bent driven in top of 1/2" iron pipe set as 1/16 M&L south 7-1961. removed 120 D raised pipe to road level. took 2 RPs.

36.67 E to ⁰⁄₀ in 2 1/2" round iron corner rock set in Conc.
43.42 SE to punch hole in S end 15" field culv.
John Kerr RPs to 1/16 7-1961. B80 P69. transit reference.
1/2" rod E 50' about 1' N of fence iron anchor 1/2" rod 50' or 100 pom
1/16 corner corner driver not described but 1/2" pipe found.
not too long. shell rock close in this area.
8-8-72 found post 50' rod under fence up 2" at 49.97
found 1/2" pipe corner near exact on line
- angle at 1/4 34-35.


Rochester 1/4 corner 34-35 #643506 (5)

Cor. Woods on Bank

March, 1851 Thos. Hunter Pg. 22 No 35 used 1/4 Cor.

1/16 North 19.91 chs. M&L - B.T.'s (N 76° E 40 chs.)(S 63° E 98 lks.)

Mees. East 39.66 chs to cen. Sec.

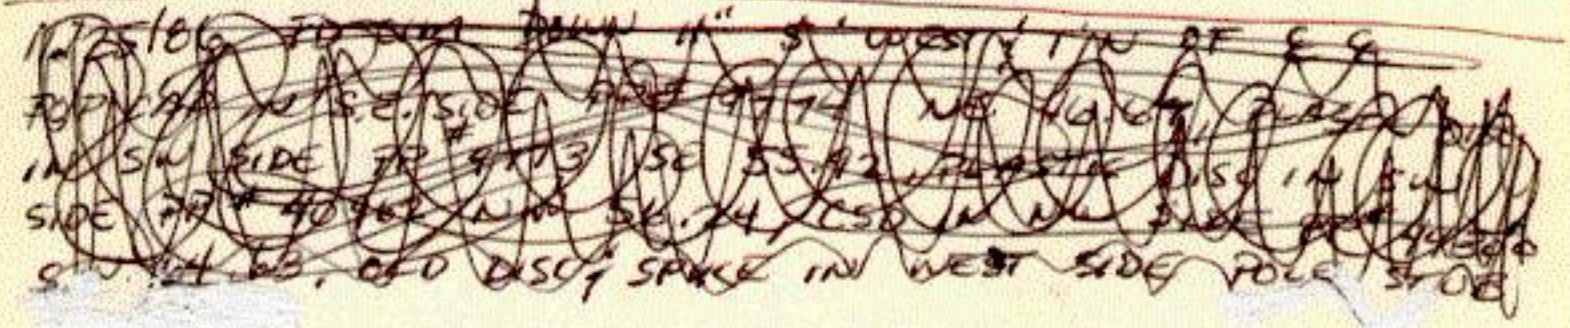

Govt Notes W.B Yerby 1854 3

40.00 Set 4 Section post

Bur Oak 10 W 75 E 185 1Ks

Bur Oak 6 S 77 W 37 1Ks