/ 6-12-1972. set C/M. over stone found - red ... 5/8"x12" (1)
6-19-1974 set a "shorty" c.c.m. over B.mon.
#650106

1/4 corner 1-2 Salem 106-15

5-1879 Hunter P360 No 351 S2. D Fallon etal.
found corner post in mound. anered by J.P. Adamson as
"fence post - corner of +c".
placed at site of orig stake.
- 1/16 west set temp point. N&L 20.02 1/2. for line north S89°50E
- north set perm. stake on line and 10 chs then
29.47 to NW cor 2. stone found.
also set perm stake 10 chs north of 1/16 temp stake west.
which came 19.99 west of point north.

4-1902 Armstrong P 34 B. J Mannanniam.
found old stake location and ~~post~~. 2' below road surface.
not mentioned
(over)

which lay 1' south and midway between fence corner posts on opposite sides of road. Evidently graded since P 360.
- Plat shows stone placed as corner as 1/4 corner.
- 1/16 east set stake N & L 19.99. for line south.
- meas south 39.77 with temp point at 19.88½ for line east. 2624.82
- 1/16 center L W 1/4 2 set stake N & L N-S 1/4 line no meas.

1965 I Karr meas from C/M set as center sec. 2 seemed rather short. - 10-1965 meas line from corner post at center 1 a C/M. (couldn't locate. no tools.) found 1/16 fence north at 1324.5 - R 1319.4 - set 120 D in road at 2640 from rail in cor post at center 1. placed on transit line over post at 1/16 - 120 D came. 4' from west edge road surface. (also pasture corner post 600' east) pipeline - 35.39 W to marker - rod meas E road 8-14-68 set ½" x 2' rod on direct line in line fence west, also line marker post 45

#650106 (2)

(2)

Card #2 1/4 1-2 Salem 106-15E

6-11-70 found 1/2" rod (8-14-68) and 120D (1965)

- set 40D 1'SE of corner post of 1/16 fence running north
- Meas 40D east to C/M at center / 1325.25 R 1319.34
  west to 120D 1316.0
- 120D east to C/M at Center / 2641.25' R 2638.68
- 1/2" rod placed 8-1968 on exact aerial line direct no meas
  in line marker post of pipe line
  RP 1/2" rod. pipeline marker post due west 36.33
  5' north, 6' east, 9.55 from 120D set 1965

RP. 120D pipeline marker post 5'N & W 30.5
1/2" rod set 1968 on direct line SW 9.55
Center Main pipeline pole SSE slope meas 126.3

OVER.

South line of SW¼ 1 near survey P 348 2635.12 actual 2635.4
corner on road at ¼ 41-2 coned come very near 2640 ± for east & west
and very likely no further south than ½ rod as 120 D R 2638.68
was set on fly-line 1 corner post at Center 1 and ¼ 10 or past west of center,
- as to line from W¼ 2 (C/M set from stone found) over
Center 2 as set, the line never run would require offset.
Doubt if corner ever will be found, same at S¼ 2 of center 2
stone coned have been found; positive proof coned be established
6-12-72 Co surv found 7 x 7 x 12 boulder in clear
black soil 2.8' down with large stake LE & stone set C/M
- corner 5.16 east of 120 D above very nearly due easterly.
- corner ~~N 25°~~ 41-42 W 19 direct line better section corners
2636.34 E to C/M center 1
35.43 5' N & W to E edge log on S side pipe line post
37.1 S W ly to S edge tel cable warning sign post
44.52 E N E to nail top & new corner post & fence east
92.94 N E to bullet hole in No Plate # 8270 W side DR

#650106

3

1-2 Salem 106-15

1/4 Corner


Set by Michael Karreck 6-1854

South on true line between 1&2

39.83 Set quarter section post in mound with trench pits charred stake and Osage Orange seeds NE & SW.

6-5-84, 10 chs. North of 1/4 Cor 1-2, Salem: Dug from a point 660' North of 1/4 Cor 1-2 (CIM) and on line to P.K. @ N 1-2 for 2'+ East, 2' North, 6' West, and 7' South to clay. Conditions fair but found nothing. Condition best on East side.

6-13-84, ¼ Cor 1-2: Dug from CIM in place as follows:
It was 5' deep to black dirt
with appx 1' of black dirt remaining.

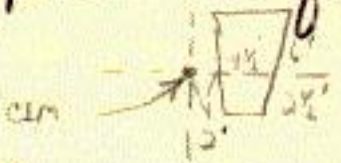

Just above the black we hit a small post which we followed down 1½' to clay but not into clay. Also found a black mark in clay 1' East of the stub. Post stub 2.12 North and 4.34 East of the CIM
6-14-84, ¼ Cor 1-2: Dug down over the CIM to see if we could determine if C. Armstrong had a fence post called for by Hunter. Removed 10" CIM, 20" CIM, and short iron. Found wood stake and boulder down 4½' and appx 2' beneath old road as described by Armstrong. Base of boulder in black dirt but not in clay. Believe stake Armstrong's or later since he said he found

1/4 Cor 1-2, Salem, 106-15

6-14-84 continued: only a stake hole. Could find no evidence of post hole or post; however, dug right under stone disturbed by previous digging. Set stone back but not CIM.

6-22-84, 1/4 Cor 1-2: Set 4' CIC/ϕ^2 at location of C. Armstrong's stone and previous CIM. Corner 2' West of ℄ N-S road and 3' South of present fence West.

RP: Bullet hole in No. plate of PP# 8270 NE 92.92
E edge of bottom lug on So. side pipe leni post WNW 41.23

C. Surveys decided to maintain previous location since already used for several surveys, although post stub found probably Hunter corner.