#650205 (1)

6-22-84 CIC/p2

Sec. Corner 2-3-10-11 106-15 Salem Twp.

No ~~known~~ record on this corner.

7-25-1974

We drove a 3/4" x 18" pipe in the center of the road & in line with the fences for Alignment for road grading. The twp. is going to grade the road for ½ mi. west of this corner location.

7-25-1974.

We dug at this cor. location from the center of the road to the North edge. - Found Nothing.

(over)

Set by Michael Karrick 6-1854

12.00 Enter wet unaultivable marsh bears East

37.00 Leave same bears SE.


40.00 Set quarter section post in mound with trench, pits, charred stake and Osage Orange seeds NE & SW.

80.00 Set post for corner to sections 2, 3, 10 & 11 Erected mound with trench, pits, charred stake and Osage Orange seeds at each angle.

May, 1867 H.E. Horton Pg. 83 No. 126 Shows Sec. Cor. used to break down S.E. 1/4 Sec. 3

1/16 West 20 chs. M&L, 1/16 North 19.94 1/2 chs. M&L

6-8-84, Sec. Cor. 2-3-10-11: Dug as follows:

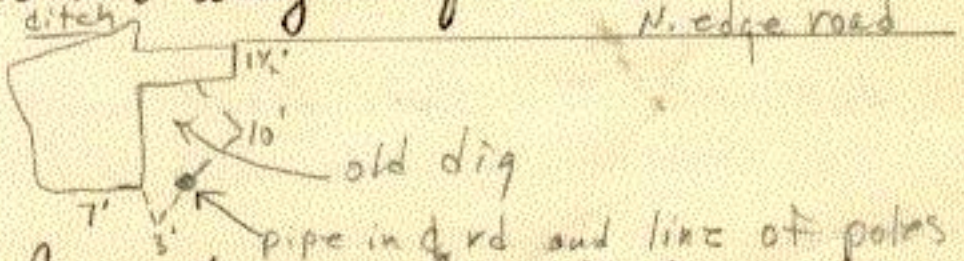

Conditions very poor. Area cut in road construction W.E

#650205 (2)

Section Corner 2-3-10-11, Salem Twp, 106-15

6-8-84 continued: were digging to cover possible fence line North (called for in 1970 survey) 10'± West of present fence South and pole line N & S line from 1/4 Cor 2-3 over fence at 1/16 South also projected to this area, but found nothing. By appearance in field, call for fence 10' West was probably and era since 1974 pipe, also set at fence line, is still in place and in line to South and is 10' East of computed 1970 location

6-11-84, 1/16 West: dug from t.n. North 11', East 3', and West 10'+ by 1½' deep of clay. Condition very poor. Road cut on North side. Found a "2" conduit with ½" re-rod .10 North — the NE prop. cor. of small parcel an an intended 1/16 cor by John Ibern. Found a possible

stake mark. 7.23 North and 2.38 East of the pipe. Mark 2" diameter and running 6" into clean clay and pointed, but no wood and no soft hold.

6-22-84, Sec Cn. 2-3-10-11, Salem: Set a 2' CIC/p² at the corner midway between 1/4 Cn 2-3 and 1/4 Cn 10-11 and in line with the fence South 1 N also by 1974 work. Corner 10' N. of the ℄ of the E-W road.

RP: CS Disc in W. side pp # 40135 N 24.87
CS Disc in W side pp # 40931 S 36.29