~~4-15-1968 set C/M over 1/2" x 24" rod~~ (1)

6-84 CIM. Corner Correction

~~Check this Corner RE.~~

1/4 corner. 3-10 Salem 106-15

#650304

~~no records~~ - H.E. Horton Pg. 83 No. 126

19 EZ ± JOHN REER

long harrow tooth driven into center black top road and accepted as corner a likely assumed line of occupation type corner.

- set C/M above 1/2" x 24" rod at location of tooth

orgties

| | | | |
|---|---|---|---|
| Disc | power pole | SSW | 49.25 |
| " | Corner fence post | NNW | 69.0 |

7-1930 B56 P54 Co H.D. found stone 8x8x15 pointed.
2.2' west center line road. 8.5 north of P.I.
- move south to assumed corner 2632.2 in line fence line west

Set by Michael Karrick 6-1854
40.00 set quarter section post in mound with trench, pits, charred stake and Osage Orange seeds NE & SW

---


May 1867 H.E. Horton Pg. 83 No. 126 shows 3 1/4 Cor.
used to breakdown S.E 1/4 sec 3
1/16 East 20 chs. M&L, 1/16 North 19.98 1/2 chs. M&L

Appx 1962: Kerr Book 86, Page 29 Set harrow tooth in
℄ black top and on line From ℄ rd @ NE 10
and a Fe cor. @ NW 10

#650304 (2)

# 1/4 Cor 3-10, Salem, 106-15

6-14-84, 1/4 Cor 3-10: Dug from a point 2.0' North of Kerie CIM as follows:

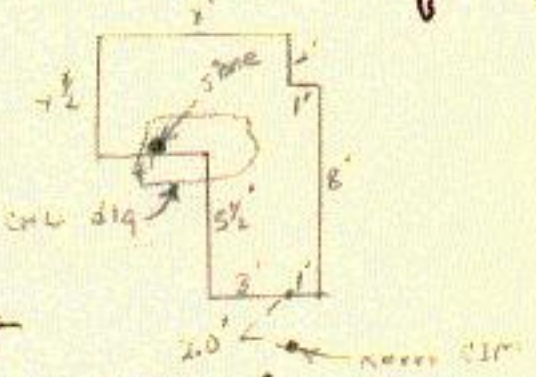


First found E'ly end of 1930 CHD dig so had to dig West to look for stone. Black dirt down 4.2 and 6' to clay so excellent conditions. Found CHD stone, a 5"x10"x12" boulder standing on edge. Found piece of metal around and beneath the stone and also a 6" long square nail. There was a small spot beneath the stone, but it did not go deep enough to determine if it was the stake mark. Found

nothing further. Set stone back and placed a 120d spike and a piece of re-rod by the stone. Stone 7.72 N and 4.46 West of Kerr CIM.

LRP { nail ENE 6.83
nail NE 6.05

6-20-84, 1/4 Cor 3-10: Set a CIM over a 1/2" re-rod over the stone found. Removed Kerr CIM and the 1/2" re-rod found beneath it. Corner 4 1/2' West of ℄.

RP's:
CHD Disc in pp # 8241 SW 48.99
CSD in NE side pp # 40933 (anchor pole) NW 36.45
CSD in SE side pp # 40144 NE 55.99

(650304) ⓒ

(33)

6-5-71
MW, RF, AE

1/4 Cor 3-10 106-15 Salem

Found CIM 4 1/2' west of ℄ CR #3 and 8' north of ℄ 10th st SW running east.

Set Ref pipe NE of Corner 42 1/2' East of ℄ CR #3 and 51' North of ℄ 10th st S.W.

TC Ref Pipe

ΔRT PK in P.P #4143 (2nd pole East of Corner on north side 10th st S.W. to 1/4 Cor 3-10

| | |
|---|---|
| 134° 39' 18" | 136° 13' 54" |
| 0° 01' 00" | 1° 35' 34" |
| 134° 38' 18" | 134° 38' 20" |

To 1/4 Cor 3-10 (CIM)

VA 86° 38' 48"

Slope 63.22 Hor 63.115

NO. 447 NATIONAL PRINTOUT