
#G5110G

¼ Corner 10-11 Salem 106-15

Set by Michael Karrick 6-1854

40.00 Set quarter section post in mound with trench pitts chared stake and Osage Orange seeds NE & SW

6-7-84, ¼ Cor. 10-11: Dug from t.n. as follows:

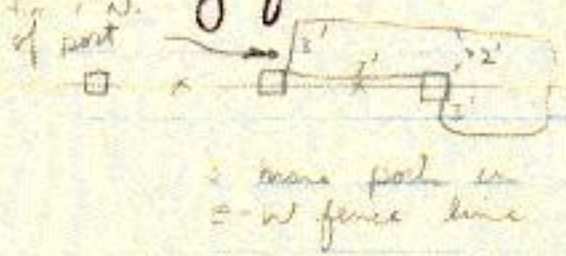

Line from pipe @ 2-3-10-11 to CIM @ 10-11-14-15 corner 7.3 East of the t.n. here. There was one very old post standing in the E-W fence line appt

10' East and 1½' South of the t.n. so we dug here first. There were many boulders in the first 1' of fill in the fence line above the natural ground. Beneath the boulders we found a cedar post stub running down to 4½' deep and packed in small boulders. As we scrapped down the wall of the hole around the post stub we found the old stake mark with some wood pieces remaining. The top of the stake was down 2 and ran down another 1½' with a long tapped point. The top part of stake appx 3" diam. We found nothing further in the dig so accepted the stake as the West corner and set a CIM over a ⅞"x3' re-rod at its location. Set a survey marker sign and post .65 South in fence line. Drove spike in N. side most ~~Easterly~~ brace post

Stake 1.9 E of stop

W14.58