/


#651209

1/4 corner Center 12 Salem 106-15

8-1856 Hunter P15 no 23 S E 1/4 11 - S W 1/4 12.

used or set corner.

- 1/16 west set M & L 19.81.

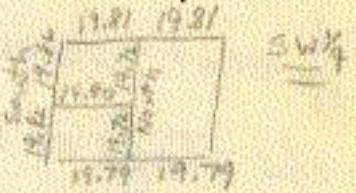

12-1857 Hunter P40 no 62. Parts 1-12- 106-15
6-7 106-14.

- 1/16 south set M & L 19.68.

BT N 56° W 1.09 — N 19° E .84

- 1/16 east set M & L 19.94

- 1/16 center S E 1/4 12. M & L 19.93 on E-W 1/16 line. N 89 1/4 W
19.76 north to 1/16 cor on E-W 1/4 line
N 5' E.

BT N 40 1/2° W .14 — N 44 1/2° E .29

(over)

6-1870 Perry P 124 No 158 L 12.

set marked stake. 57.75 104.53 / 157.57

BT 12" oak N 85½ E .87½. Marked & blazed.

1/16 west - reset 1/16 corner correctly formerly set P 119.

- the stake at center also corrected of P 119. 104.44 / 169.13

B tree then 12" oak. N 82½ E .98 69.60 this stake found P 119.

- 1/16 corner on P 119 west N 8 L 19.77. now different but

doesn't say what. B. tree 4" Oak N 14½ E 1.02½

formerly N 26° E 1.12

5-4-78 Dug from the 5/8" rod (found on the East side of the corner post and used as a t.p.) 2' N., 3' E, 3' So. and 4' W by 1½' deep to clay. Found nothing. Set rod back.