
#651409

1/4 corner. Center 14. Salem 10 6- 15

4-1911 Chas Larson P154B S14 Fuller, Knusel Feigle.
No mention of corner, corner numbered on plat
evidently run in by inters lines as meas different
and conflicting

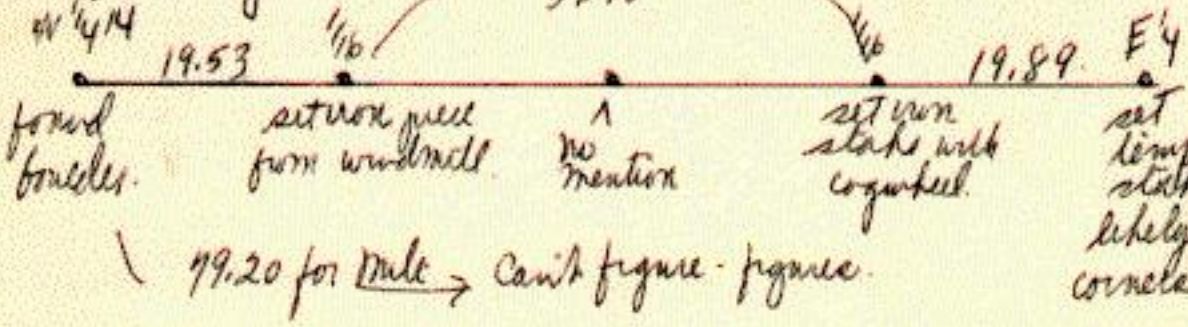

10-1996

"651409" Cen 14 | Salem 10S-15

Vince Forgman computed center at

intersecting quarter lines