T 10-1-70 set C/M overlong stone & 1¼ x 19" gal pipe

¼ Corner 17-18 Salem #651706 (1)
106-15

5-26-1893 W Fraser P508 No 477 L18 A Severts, T Isaacson, A Christian
Corner could not be found, set stone M&L 39.94
- 1/16 south set boulder stone M&L 19.97 (1318') to L E18a 8x14x24 stone.
- 1/16 west set boulder stone M&L 20.01 to center 4x12x12 stone.

5-29-1893 W Fraser P510 No 478 L17 Nels Jacobson, B Johnson
C Anderson, Salem Board
found stone P508.
- 1/16 south found stone P508 1997

6-12-1935 J Kerr B10 P5
Mix east line 17 May have used corners on West line.

over.


7-1969 J Kerr meas from SE18 (CIM) north set ~~rod~~ nail on random line in center new blacktop. came at 2637.15
R 2636 or near record

7-18-69 J Kerr found 1/16 stone south line remained the same. - station from SE18 1316.6 R 1318.0
set hard nail on line 3.8' south of nail set previous line
of meas is constant that should be true 1/4 corner 17-18
-16 west drove 3/4" rod in center black top on exact N-S 1/16 line
from stone found on N line 18 to midway point on S line 18. No meas.
it comes 16' west of fence north.
-16 south found stone 5X 8X at least 16" very rotted & alone in clear
land with top flush with soil (mossy) No wash no erosion or blowfill
came. 4.5' E to center 24" live barrook south edge .8' north of corner
post 1/2" x 4' rod up 16" on each side set ring of boulders & limerock

County survey of road prior to survey
B276 – R3±
#651706 (R)

Card # 2 — ¼ 17-18 — Salem 106-15

P 508 W Fraser 5-1893

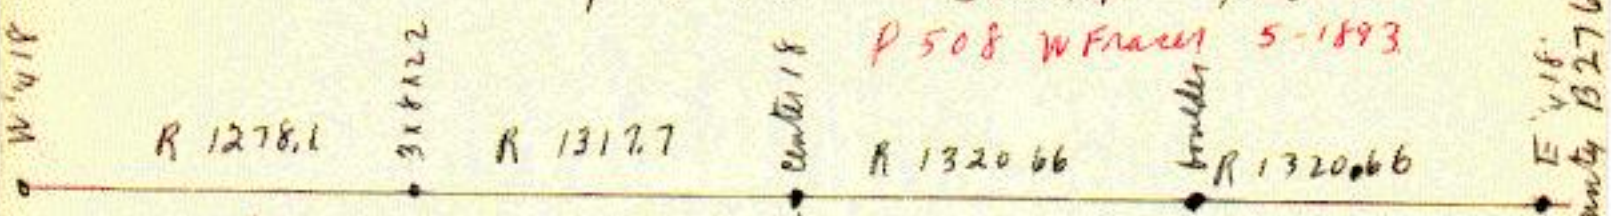

topo of ℄ 1/16 road south 1308±
" ℄ " fence north 1305
this checks 1305 + 16.' – 1321 near record.

topo of center sta from ℄ 1/16 road south to north south fence at center 1349.
total from 0 0 E ¼ 18 to fence N-S at center 2657. R 2649.3
so fence at center some 16' too far west

from county 0+00 east to N-S fence 2569.
2569 + 16 = 25 85.0
R 2595.8 – 2585 = 10.8 west of 0+00 ±
so dig 10.8 west ± after establishing Northing

9-29-1970 Co surv. after setting nail as Center 17 on true N-S 1/4 line and 2635.4 north of 1/4 17-20 stone. ran line aerial carefully from C/M at 1/4 16-17 over this nail to west line sec 17. point came only .33' south of hard nail set 7-18-1967 at 2633.35 from SW cor 17. over 1/16 stone and double distance. apparently 13/16 67½' K 1318.0
— must dig thru blacktop to set C/M will dig deep enough to see if stone recorded still in place. terrain favorable

---

10-1-70 dug 18"x 30" hole in black top and 12" rock base below. found large boulder 10x15x16 lying flat on top of limestone with 2"x 8" top quite long 3.5' below top of black top road.
— set 1¼"x 19" galv pipe over 2 stone with C/M flush with road surface, nearly.
— the corner came 3.63 south of nail set in Center road 2637.15 North of SE cor 18 or. 2633.52 & to SE 18 ½ 1316.76 see card #3

#651706

Card # 3 1/4 17-18 Salem 106-15 (3)

- corner came .36' west of orig line set over 1/16 stone N and E cor 18 - will cause C/M at NE 18 to be moved .72' west and to station 5267.04.

C/M now on old line at 5263.2 a compromise measure caused mainly by line from true 1/4 8-18 over stone found (not vertical) at 1/16 east.

- C/M at NE 18 will go .72 W and 3.84 north.
- will help meas west to 1/4 7-18 R 2634.2 now 2635.35
- corner came .48' north of line proj in from east 1/4 17 over nail set recorded meas north from E 1/4 17 2635.4 which will move north .24' to 2635.64

over RPs

- Double Co disc on NW side PP #8576. up. 7' NE 62.73
- Orang cap on W side new 5" cedar Cor post 6.6' E & S 45.5
- punch mark on clamp lug east end road culv NE 48.12.
- " " " " " " west " " " NW 44.53
- corner line 3.43' south center E-W road.
Near east edge farm drive south, 2'+ west & road north.
- punched aerial line meet from CIM over 1/16 nail west & center 18 area - this nail 1314.35 N & 1/16 stone set as center NW 1/4 18 - considered this stone No 2 Comp 1314.6
11-10-70 finish aerial found line 1.87' south rod at 1/16 west, .47' south & nail at center (set 1320.66 west & 1/16 rod), 1.1' north & nail orig set & at 1317.0 west & nail at center

#651706 (4)

1/4 Corner 17-18 Salem 106-15
Set by Michael Karrick 6-1854
40.00 Set quarter section post
Burr Oak 15 S 47E 225
Dug trench

(651706)

11-09-99
mw RF

¼ Cor 17-18 10S-15 Salem 65
Fd CIM 2" deep in Blacktop CR#25
in good Condition. The Corner falls
3½' South of ℄ CR#25 and 2½'
West of ℄ 109th Ave S.W running North
Old CKD disk in PP 8576 NE 62.79'