
1 9-22-70 set CIM mon ½"x30" pipe orig ~~mon~~ Laing M Wade
9-29-81 set CIM deeper #651904
¼ Corner 19-30 Salem 10 6-15 #1

11-1903 C Armstrong P68B 19.
H Ananba, Fred Leon
found stone 10x12x12 on running line mkd from
SE cor 19. at 39.89 , on line
- 1/16 east found stone at 19.97 (1318.0 from SE 19. on line then 2008 to ¼ 19-30
- 1/16 west found slake at 59.84 " " on line

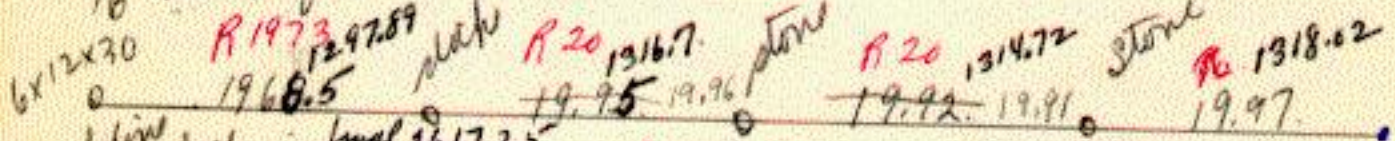

- 1/16 north stake M & L 19.91

over

9-22-1970 Co Surv. inquired at farm of George Evjen who said stone was in. found abandoned road in 3' cut made years ago road stable and found stone in north track 8x12x16 lying upright but not in longest way. set ½" x 30" pipe below C/M with stone on north side about 6" deep. road slopes up to west 8% grade. for 100' or better. corner will stay if left alone. Stone on N side.
RP — PK nail in 8" cedar cor post (Unio Munn boy) 2' W & N 17.02
— Repair cap on S side huge trans pole # 95 (bullet hole in top) WNW 71.26
— sight line from E side of east pole to pole line N — west 66.2
— corner recorded as on line — proj line from LW 19 east on random, missed 1/4 19-30 .46' line N of corner. set nail at 754.15 on high land east.
9-29-70 found SE cor 29 iron bar recorded 11-1903 Charm P 68 B. corner false .12' south random line 2635.56 east of 1/4 19-30 re set from stone found. R 26 32.74 (2.82' over)

see Card # 2.

Card # 2 1/4 19-30 Salem #651904 #2

as corner set at 1/4 19-30 came .46 south & random and SE 19 came .12 south and stone at 1/4 19-30 being large over 12" corner could easily have been set on line .06 south & random so center C 1/4 of too far south

- also found considerable portion & wood stake at 1/16 west set by Ch Armstrong 11-1903 P&B in clear black soil in old road unused for many years only used as field road

- this stake was .8 south & random

1299.45 east & SW 19 R 1297.89 long 1.56

then 17.8 east to 1/4 19-30 R1316.7 long 1.1

drove 3/8" x 24" rod thru wood stake, stake left at area

- corner exact line fence south 17.8' north & 5½" Conrad filled steel corner post & fence south - post leans some south.

Set by Michael Karrick 6-1857
on True Line
39.73 Set quarter Section Post
Burr Oak 12 N 18 E 345
" " 9 S 15½ E 256

9-29-81 ¼ Cor 19-30 : Found CIM broken and stone exposed in deep wheel rut in old road. Removed CIM and stone. Drove pipe found beneath CIM deep and set a new CIM over it. Reset stone on South side of CIM. Set survey marker sign and post 3½' North. Stone 5' North of center of old road