X 9-22-70 set CM over 1¼x36" pipe org stone found 1947 deep below (1)

section corner west 19-30 Salem 106-15-

#651905 each 24-25 Canada 106-16 Dec.

6" brook S60°45'E 89 L. 58.74

5-1894 W Fraser P92B 6 sections Salem town board survey P92B 6-1905 but corners on town line (see below) placed 5-1894. stone corner gone so set stake on town line midway betw. W ¼ 24 & W ¼ 30 39.87½ (2631.75)

Placed corner at perp mac also between SE 19 and ¼ 24-25 106-16


11-1903 C Armstrong P68B 219 Y Anauby, Fred Leon found burr oak stake 15" deep and SEly 16" BO S56°44'E 89 lks (58.74') marked trd.

– set sandstone 6x12x30 as witness to stake on North side old stake

– 1/16 north set stone 6x12x16 M & L 19.90½ (1313.7)

(over)

- 1/16 last found stake on line at 19.67

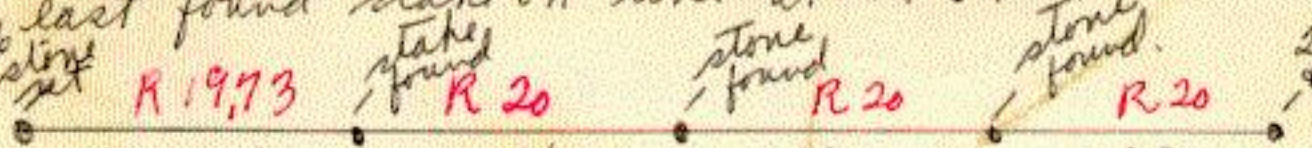

9-17-47 J Kerr Dodge Fillmore Book P 58. (Broken back corner) found stone after extensive deep digging. set 1¼" pipe in place of stake south of stone

New bearing to corner Bur oak S 67° E 58.2'

- shows mean south to W ¼ Sec 2632.7

9-22-70 Co Surv - found pipe at road surface battered on top by machinery pulled pipe put 38" pipe into place below C/M & glass.

- Nail in hub on N side 16" br oak sucker & Marks B.T. on above bearing			57.0
- Iron mon bnd PK in Cross on bolt S end		NE	38.4
- Alum pipe cap on NE end P P # 3813		SSE	70.55
- 0.0 mark on top center of 36" culv.	east end	SSE	65.66
"	west end	SSW	64.11

AG51905 (2)

Section Corner West 19-30 Salem 106-15
East 24-25 Canisteo 106-16 D. Co.

Set by John Ball 10-1853
80.00 Set post and drove charred stake corner to Sec's 19, 24, 25 & 30 Built mound with trench per instructions. Planted 1 SE Osage Orange NE Apple seed.