/ 6-19-72 set CIM mon orig L stone and 3/4 x 12" wit
#652206


1/4 Corner 21-22 Salem 106-15 (1)

3-1895 W Fraser P618 No 561 S21 D Lillo, H Lillo
O Glen, Samaland

Corner gone, last no evidence or knowledge 2630.72
set stone 3x6x20 and marked stake M&L sec 1/16 ch.
-1/10 north set small stake M&L 19.93. 1315.38
-1/16 center NE 1/4 21. set marked stake [redacted] inters lines
-1/16 west set stake & stone M&L 20.00. 1320.0.
also set stake M&L 9.97 north of above 1/16 stone.
-1/16 south set small stake M&L 19.93. 1315.38

mon.

6-19-92. found recorded sized limestone 3½' disp. in east side of wye stayed road turn off north. - corner. 4'± north of N edge road.
- set C/M over stone and ¾ x 12" iron - found long stone with some tilt easterly. so erected stone

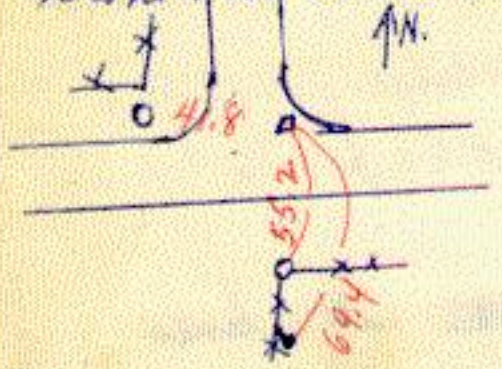

41.8 little N of W. to pepsi cap N side of P.P. # 41258. pole in line West road fence running north.

55.2 S to porcelain ele fence insulator. on W side leaning corner post. in line fence east & south.

69.4 S to edge steel Tee stayed steel fence post securely grown into SE base of clump boxelders.



See Center 21 for Meas & ⅛ West

#652206 (2)

1/4 Corner 21-22 Salem 106-15

Set by Michael Karrick 6-1854

40.00 Set quarter section post in mound with trench pits, charred stake and Osage Orange Seeds NE & SW.

7-25-77 Reset corner for road grading. Set ½" x 6" rod in center of road N (and SE¼ of pp # 7906) at 349.14 and on line to ½" x 6" rod set in center of road N (E of pp # 7907) at 665.96

7-25-77 1/16th West — Reset corner for road grading.

RP's Spike (up 5') in SE side 14" Burr Oak NE 95.44

Sp. & CSD in E side 13" Burr Oak (up 5') NNE 86.73