X 11-10-70 set ~~3/8 x 4' rod~~ M & L 2632.7
8-13-1980 - Set CI Cap/P² - 0.65 N. & 2.54' E. of former Rod (1)

1/4 corner 26 - 35 Salem 106-15
#652604

6-1887 Hanler P420 No 409 L26 Alice Starkey.
Corner could not be found by careful extensive search & digging.
set stake driven well down M & L 39.95 1/2 (2637.03
-1/16 west set stake M & L 19.97 3/4 marked 1318.51/2.
with stone north & above 1/16 on line to 1/16 east & W 1/4 26.
this stone 9.96 2/3 north of 1/16 corner. ~~9.96 2/3~~ 29.90 from N
-1/16 north set stake M & L. 19.93 to stone set at center 26

10-27-70 Meas from SW cor 26 east along ℄ road & fence line
set nail at 1318.5 which came well west of center road North
- flagged nail on brace of fence line south. 2633.6.
- set 20 D east of nail at 2637.0

Over

Cont Meas east to PK & Co Road 15. - 5266.0
Making fence wires & fence running south nearly exact Midway
- set (5) on steel fence post on W side Co road. North 36.9 within .1±

11-10-70 Co Surv. (5) 36.9 at 26-27-34-35 North of C/M
Missed PK in black top accepted as 25-26-35-36 North 48.15
- Meas south from PK in 1969 came 5279+ to Co nail in center
E-W roads 5285.28 record 1873.
- Meas north from PK - 4/16 fence east 1316.8±, found stone at
1/4 25-26 at 2633.75 R 19.94 N&L 1316.04
- Midway point at 1/4 26-35 came 3.7 south of fence corner E-W-S.
- PK could not be moved more than 1 or 2' north at mash.
accepted PK as corner until proved otherwise.
- dug 5' deep for stake set well down, delta area from field north
stake could be deeper or gone - set 3/8" x 14' re bar on line and
Midway 2632.7 from PK and C/M - Mound, brand 10-28-70.
- Corner post N 3.7' — 60 D in base Wire 16" brOak SSW 63.75

#1652604 (2)

1/4 Corner 26-35 Salem 106-15

Set by Michael Karrick 6-1854

$40.00 Set quarter section post No trees of sufficient size for bearings therefore erected mound with trench pits, Charred stake and Osage Orange seeds NE&SW.


7-3-1980 (1980 Remon. Book) 1/4 Cn 26-35: Dug from a point 1' East of 3/8" rod set in 1990. East for 3' and North for 3' by 4½' deep to clay. Found nothing.

7-29-1980 (1980 Remon. BK) 1/64 N of 1/16W: Dug small hole in N-S road. Immediately struck 6"x6"x27" limestone down 15" and dug well into clay. There was a drill hole or chisel hole in the top of the stone

and the hole had split. Stone .15 N and 1.78 West of t.n. Put a RR spike and a V-shaped piece of iron on the West side of the stone.

7-29-1980 (1980 Remon BK) 1/16 West: Point come on East edge of farm driveway. Dug small hole and found a culvert had been dug in and the area was cut well down into clay.

8-6-1980 (1980 Remon BK) 1/4 Cor 26-35: Dug here again to cover the 1/4 line across Section 26 which comes appx 2½' East of 3/8 rod. Found nothing - not even post

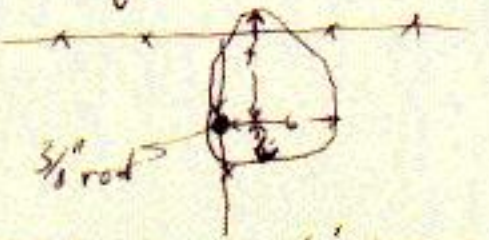

8-13-1980 Set a CIC on a 6' piece of telepan at the corner at intersection of line from the N 1/4 Cor 26 over the Center 26 and at the line from NW 35 to NE 35. The corner came .65 North and 2.05 East of the 3/8" rod (removed) set in 1970

1/4 Corner 26-35 Salem 106-15 #652604 (3)

7-29-1980 continued: Corner 2½' South of fence East and 2½' East of fence South.
- Spike in SW side corner post (with survey sign) to fences E-W-S NW 3.62
- Spike (up 4½') in West side 15" Burr Oak SW 65.20
- Spike in So. side 8" Elm in fence East E 69.28