X 10-14-70 set 1¼" x 16" pipe over drill steel in ~~dirt~~ blacktop
11-9-78 CIM
#652805 (1)

section corner 28-29-32-33 Salem 106-15
6-1905 Jr Fraser P92B & 19-20-21-29-30, Salem Board.
drove stake from course & dist of NEBT stamp.
-1/16 north drove stake N & L 19.92 (13 14.92).

5-1928 J Kerr Book-2 P 37.
found iron stake, placed 2 boulders one above, the other,
top stone 10" x 21" with cross.
- meas south leng 28 5281.7.

12-1939 J Kerr P556B, Book 14 P18-19. C Paulson
found 2 boulders placed pipe riser.
- set iron pipe east 660.77 (over)

- set limestone as 1/4 corner at 2640.84.
- meas north 2631.7 on slope actual 2627.3 ±
set midway with pipe 33' east. also pipe 33' corner.
set pipe. 13.17 north of pipe east of corner.

1968- now iron in blacktop.

Nail or disc		tele pole	NE	61.05
~~" "~~	~~" "~~	~~" "~~	~~SE~~	~~45.35~~ gone 10-6-70
" "		power pole	NW	71.52. 1966

1-1935 B79 P20 stone mon. meas L 5276.2 1935

7-1966 B363 boulder P41 Lp FP NE 61.0 meas L.
LP FP SE 45.72 LP FP SW 72.65 5274.12.
P.P in PP NW 71.51

10-6-70 Co surv NW power pole still in, tele pole NE now stub still in tele SE gone — New trans power pole # 40244-pepsi NW side NE 46.15 corner a nail, strong dip, 2.7' E 1.0 N ± of center intersection

See 28.32 for survey 20 A SW cor 28.

#652805

(2)

Card # 2 28-29-32-33 Salem

Conc mon.

10-14-70 Co surv found 1/4 28-29 set right for line with
- found nail at above corner dug in black top found top of drill
steel rod some .8' N Westly of nail down 14"
- set 1"4x16" galvpipe over drill rod & sealed in black top
flush with road surface

believe error

- New RPS Knee on power pole
- Knee on stub-of old tele pole (post height)
- Paper cup on NW side PP # 40244
- Knee chiseled on fence post

NW 7.06
NE 6.07
NE 46.16
SW 12.65

- dug for mon prop 660 ft east on property corner for
20 acres found nothing, dug with tractor
not shown on survey P 558 B evidently wrong also
information as to what set and were dug entire area to clay

1933 - Co HD B76 PT.
found boulder 1' below surface of road.
Sta 209+05.8 end of road alignment from north.

Meas north 2632.69


12-5-72 checking W 7 traverse line north using new C/M's set at 1/4 28-29 and 20-21 28-29 7-1972 when Conc Mon. were both found wrong. see 1/4 28-29 South 1/2 mon 2627.28 north 1/2 mile 2628.94 W F M & L 2629.44 dont believe corner now in place correct, could be south up to 2' and west some (no final aerial run but would be simple matter on one set up.

1/4 20-21 2629.44 2628.88 20-21 28-29 2629.44 2628.94 1/4 28-29 2629.44 28-29 32-33 nail 2662.6 1324.8 county 52 14-21

set by Michael Karrick 6-1854
80.00 set post for corner to sections 28, 29 (32 33)
Burr Oak 12, N 24E 199
Dug Trench

Section Corner 28-29-32-33 Salem #652805 106-15 (3)

5-20-77 Dug down at pipe. Found pipe over drill steel on North side of boulder 2' deep. This boulder 19" long and set over another boulder 18" long. Large spike on W side of top boulder but found no iron. Boulder well down in subsoil. Dug W. 3'+, N 3', and S 3' Found nothing. Road cut.

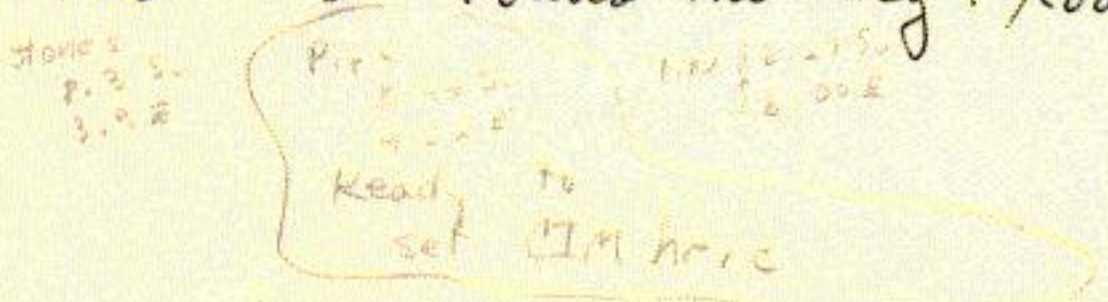

11/9/78 Set a CIM over a ½" x 2' rod at the 1977 pipe location (used 1977 tie nails). The corner is 1½' East of the N-S road and in ℄ of the roads East and West

RP's: Pop Cap in NW side pp# 10244 NE 46.13

Old C.H.D Disc in NE side pp# 7546 NW 70.85

Punched "+" in lug in top S. end 18" C.M.P in road East SE 32.45

The stone(s) is .33 South and .53 East
The t.n. is 1.99 West and 1.96 South to NO



Do not use until checked but would agree with 1966 tie if subtracted .8 ft