X Conc mon near road surface in place.
7-3-72 set C/M nail Conc mon

#652806 (1)

1/4 Corner 28-29 Salem 106-15

6-1905 St Fraser P92B S19-20-21-29-30
Salem Town Board.

Could not find corner, set stone and stake
M & L. 19.92. (1314.72) or 2629.44

C
12-1939 J Kerr P556B S28 B17P18+19 Paulson.
found limestone set 3/4" rodon west side.
Cross in each headwall culv (buried) NNE 68.0
Disc in power pole NW 41.3
tile bell post west and 3' south.)
4-1953 corner 4X16X8 limestone. ones.

Corner now a 8 x 8 x 30 capped conc mon.
Very close to top of present road.
Disc in top fence post SW 45.0
Meas south to SW 28 (1939) 2631.7 meas on slope
actual 2627.3 ± computed.
angle section line south and 1/4 line east 89°36'
Meds east 2638.6

10-14-70 Co surv used corner for line south - found County conc mon Top, seemed to tilt slightly east will have to remove & set C/M
- Nail & disc in PP # 7625 NW 42.06 was 41.3
- + shaped cross in east headwall some 1' south center bridge. calc NE 68.69 was 68.0
- Tel box post (very wobbly) 4' SW 29.0 ±

Card #2. 1/4 28-29 Salem 10-15 #6528062 (2)

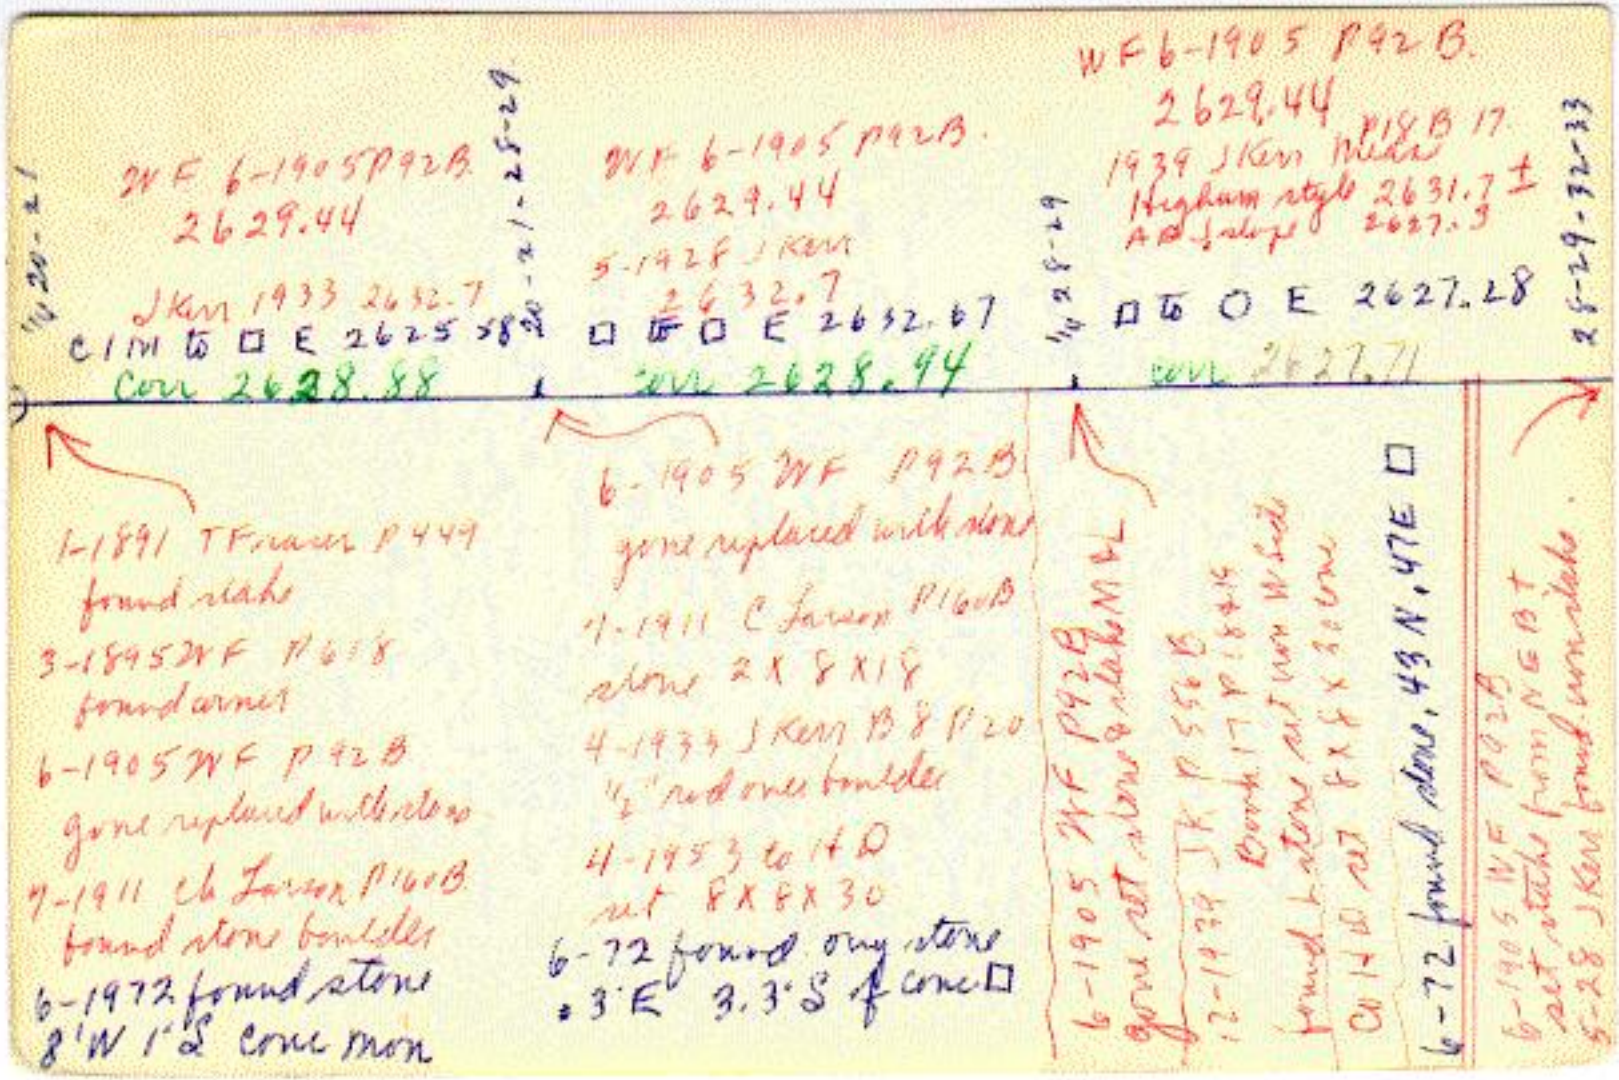
dug out concrete monument and found limestone about 4 x 8 x 16 as recorded but stone vertical but on edge of side not on bottom. Measured carefully the RP from the cross in culvert NE and tried to set corner on 68.0' and center stone -

set 5/8" x 12" rod below conc mon below C/D

68.04 NNE to the cross on E Curb headwall

42.06 NW to old iron on SW side PP 7625

30' ± 4' SW To rivet in N side ☐ lib cable pedestal


WF 6-1905 P92B
2629.44
JKen 1933 2632.7
CIM to □ E 2625.58
Cor 2628.88
1-1891 TF Jarvis P449
found stake
3-1895 WF P618
found corner
6-1905 WF P92B
gone replaced with stone
7-1911 CB Jarvis P160B
found stone boulder
6-1972 found stone
8'W 1'S cone mon
WF 6-1905 P92B.
2629.44
5-1928 JKen
2632.7
□ to □ E 2632.67
cor 2628.94
6-1905 WF P92B
gone replaced with stone
1-1911 C Jarvis P160B
stone 2X8X18
4-1933 JKen B8 P20
½" rod one boulder
4-1953 to 4D
nail 8X8X30
6-72 found orig stone
3'E 3.3'S of cone □
WF 6-1905 P92B.
2629.44
1939 JKen Misc P18B 17
Higham style 2631.7 ±
AD slope 2627.3
to O E 2627.28
cor 2627.71
6-1905 WF P92B
gone, set stake on lake bank
12-1924 JK P556B
Bank 1.7 N 18.4 E
found stone set from W end
mon 4X4X24 cone
6-72 found stone, 49 N, 47 E □
6-1905 WF P92B
set stake from W end
5-28 JKen found mon stake.

#6528016 (3)

V4 Corner 28-29 Salem 106-15

6-1933 C.H.D. Book# 76 page 6 fd stone

Set by Michael Karrick 6-1854

40.00 Set quarter section post

Burr Oak 10 S 20 W 223

Aspen 10 S 50 E 306

40.50 Creek 4 lks wide runs NE and leave Aspen thicket bears N.W.