9-10-1981 Set C.I.C./p² at 1977 location

#LS3004 (1)

1/4 Corner 30-31 Salem 106-15


Set by Michael Karrick 6-1854

39.97 East on true line

Set quarter section post in mound with trench pits chared stake and Osage orange Seeds NE & SW

5-19-77 Dug with backhoe in Co. Rd. 17 centered [redacted] on a point on line and at prorated Govt measure. This point came approx 16' East of of fences North and South but was in line with row of old posts North and 4'+ West of line from the corner post at the Center 31

over the 1/16th North (Nail W. side of post)

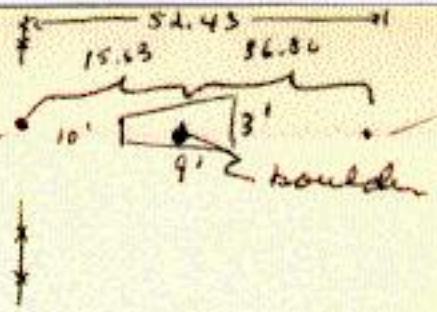

Found 6" x 8" x 16" boulder 4' deep in black soil beneath oldest road. Stone 36.80 West and 2.25 So. of T.N Set a 5/8" x 21" pipe at the surface of the road over the stone.

R.P.'s Spike and CSD E side 3" Elm

CSD S. side of pp # 38277 NE 109.91
NW 131.47
Spike and CSD in root Easterly of triple 9" Cherry
NNW 71.77
Punch mark top lug W. end 14" C.M.P to driveway So.
SSE 29.87
Corner 2' So. of ℄ and 16' E of present fence
N+S

1/4 Corner 30-31 Salem 106-15 (2)

9-10-1981 Set C.I.C./P² at 1977 location in #653004
place of 5/8" pipe (No new ties)

(653004) & (15)

5-25-74
mw, mc, RF

1/4 Cor 30-31 106-15 Salem

Set Ref pipe on west edge field drive 37 1/2' South of ℄ CR # 17

πC Ref pipe
XRt PK in P.P # 38277 (1st pole west of 1/4 Cor on North side of CR 17)
to 1/4 Cor 30-31

50° 56 06"	51° 41' 06"
0° 01' 06"	0° 46' 18
50° 55' 00	50° 54' 48

To 1/4 Cor 30-31 (CIM)
VA 84 40 42
Slope 35.28 Hor 3513

πC 1/4 Cor 30-31 (CIM)
To Sec. Cor 29-30-31-32
VA 89° 34' 16"
Slope 2640.11 Hor 2640.03

To pipe @ prop Corner
515' West of Sec Cor 29-30-31-32
VA 89° 56' 02"
Slope 2125.10 Hor 2125.10

NO. 447
NATIONAL PENNTRUST

"6530OH"	1/4	COR	30-31	10S	15	SALEM

SURVEY CREW SET PK NAIL AT SURFACE FROM TIES.

10-20-99 HPA MC