
10-27-70 set C/M over RR spike in bed rock in place of bottom lemaing of orig L stone. (1)

Section Corner south 34-35 Salem 106-15
north 2-3 R Dell 105-15
#653505

3-20-1889 Thos Frazer L 34 21 Y Scott
unrecorded in book XXX pages 1 and 2
- laid out plot on east side of SE 1/4 34
29.95 2/3 chs 1977.36' from SE cor 34 which was
described as found stone in middle of road
- No mons north but found cedar stake at 1/16 corner
north & stake found at 1/4 34-35
- found the stake at 1/4 34-35 was 8 2/3 chs 572 east
of direct line between 1/16 stake mentioned and SE 34 (over

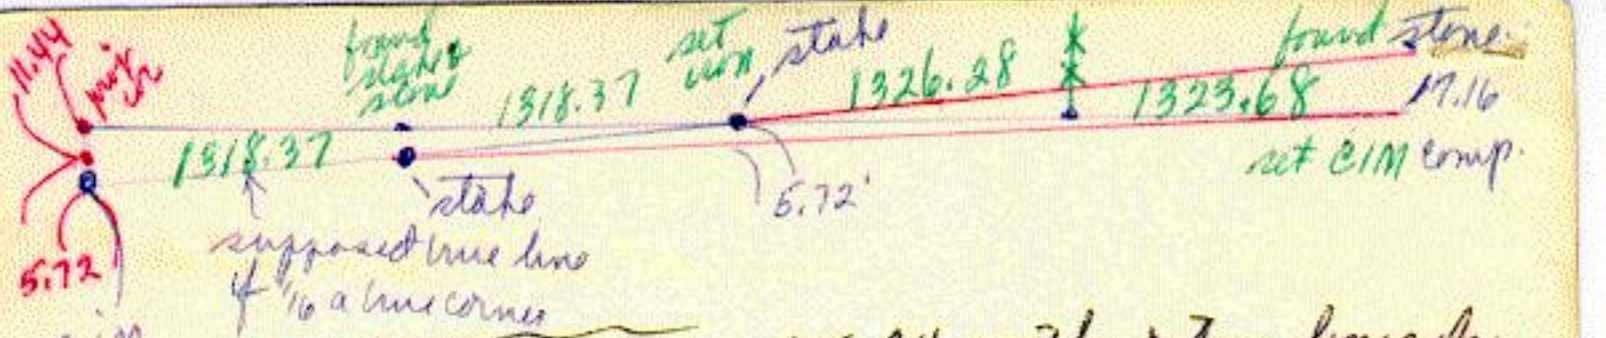

10-21-70 Co surv. meas from NE 34 south rolling lines of fences & orig 1932 meas of J Kerr of N 1/2 26 37 5
- set nail in line fence west at 5291.65 after finding 1/16 stone
re-run line on data above, from true 1/16 over point 5.72' west
& nail set on true proj line from NE 34 over 1/16 found.
- set nail opposite orig nail set at 5291.65 ignoring line & orig nail
- 10-27-70 dug with tractor carefully top surface only removed
- found less than 6" shattered bottom orig stone very plain with
dark portion & orig. digging showing in clay clearly.
- set C/M over RR spike set in bed rock after baring
out much & top part orig shell rock formation.

see Card # 2

#653505 (2)

Card #2 S 34-35 Salem 106-15
N 2-3 Rock Dell 105-15.

10-27-70
- found stone 4.95 N of Nail set as T Fraser set See #1
" " 4.7 W " " "
- Thos Fraser said a line from 1/16 stake to stone found would come 8 2/3 lks (5.72' west of 1/4 34-35
- as stone found came 4.7' west of nail set in this manner would appear to miss more. In placing NE cor 34 .6' east (11-28-70) and rod at 1/4 34-35 .6' west stone would come 2.9' west of projected line so 5.72' would become + .96 or 6.68'
- if line from NE 34 direct to SE 34 line would miss corner as set more yet. 10.02'

over RPs.

RP CIM Pepsi cap SW side PP 7495 SE 56.65
" " SE " " 7496 NE 49.58
final " " E " " 7494 NNW 108.4
tele box # 29 on line beyond above pole 11.5'
Pepsi cap SE side PP #7497 SW 58.5
corner lies 3' S & road E, 3' E & road N-S.
5' N fence line west.
- total mile N & S 5286.7
- S 34-35 N to 1/16 fence east 1323.68
1/16 fence east N to corner set as 1/4 34-35 1326.28
1/4 34-35 N 1318.37 M&L from 1/16 stone found.

Set by John Ball 10-1853
80.00 Set post Cor to Sect. 2, 3, 34 and 35
Burr Oak 5 S 35° E 247 links
Burr Oak 6 N 88° E 592 "
No other tree near, Dug trench per instruction