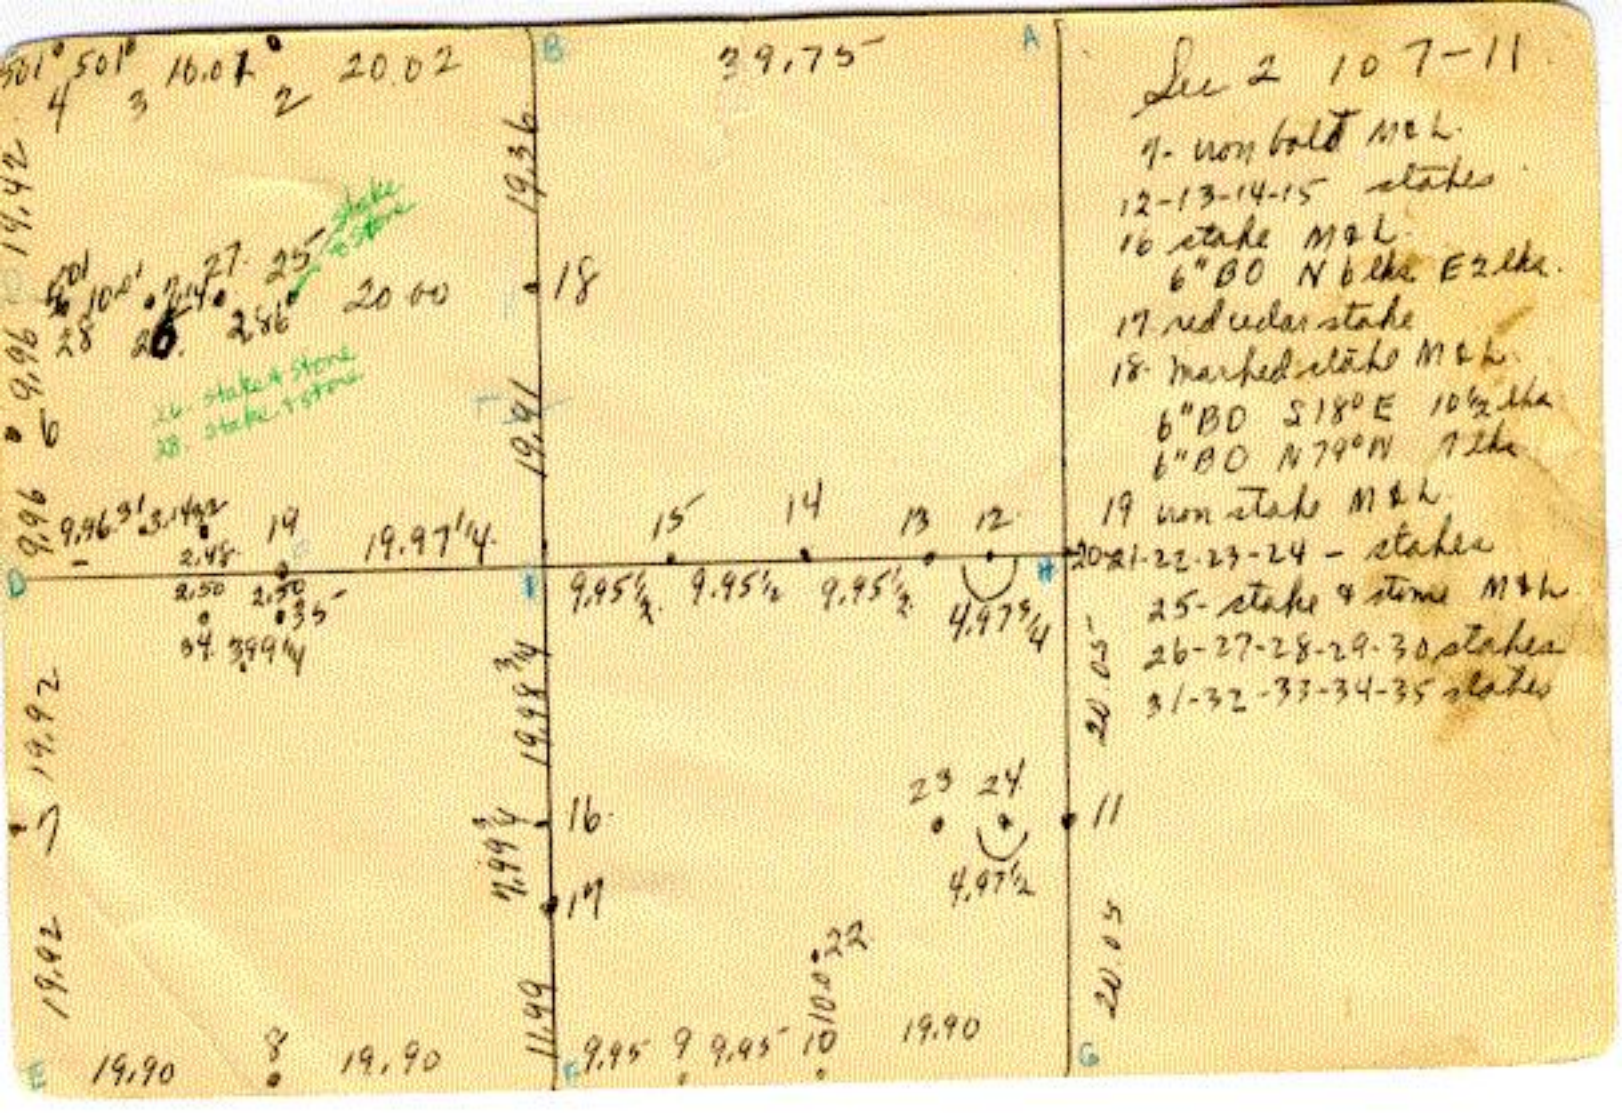
1 6-29-77 CIC #710209 #1

1/4 corner Center 2 Quincy 10 7-11.
see field bkg p. 61-67
10-11-1900 W Fraser p 692-8 no 615 S 2 3 10-11 9 parks cor NE 2.
set marked stake and stone 6 x 8 x 27 by side at true
inters lines. took B tree 6" elm N 15½° E 26 ¼ lks (17.33)
Hackberry ~~Oak~~ 6" S 7° W 32 lks (21.12)
1/16 east "14" stake M & L 19.91 1314.06 - 2628.12
1/16 south "16" stake M & L 19.98½ 6" burr oak 1319 north 6 lks east 2 lks.
1/16 west "19" iron stake M & L 19.97¼ 1318.18 - 2636.37
1/16 north "18" stake ~~[illegible]~~ 6" burr oak S 18° E 10½ links.
6" " " N 79° W 7 links.
on line 1301.35 Then 1277.92

5264.49


Sec 2 10 7-11
1- iron bolt M&L
12-13-14-15 stakes
16 stake M&L
6"BO N 6 lks E 2 lks
17 red cedar stake
18 marked stake M&L
6"BO S 18° E 10½ lks
6"BO N 79° N 7 lks
19 iron stake M&L
20-21-22-23-24 - stakes
25- stake & stone M&L
26-27-28-29-30 stakes
31-32-33-34-35 stakes
39.75
20.02
20.00
19.97¼
9.95½
9.95½
9.95½
4.97¾
4.97½
19.90
19.90
9.95
9.95
19.90

#710209 #2

¼ Corner Center 2 Quincy 107-11

6-29-77 Found Will Fraser's recorded stake with stone alongside. Top of stone down 1½'. Set CIC/p² in the stake hole and set stone on the West side up to ground surface and steel fence post on the West side of the stone.

RP: Sp and CSD W side blazed 11" Walnut NNW 34.05
Sp and CSD W side 4" blazed Walnut S. 37.83
Sp and CSD E side 19" Walnut SSE 52.85
Wild Boy tree gone.