X

#710705 (1)


section corner West 7-18 Clancy 107-11.
East 12-13 Viola 107-12

6-1877 Hunter P317 no 311 Sec 7 Sw Smith.
"Quote - found stake standing and also Sw witness tree
- 8" brook S63W 52.8' Tested stake by said witness
tree and found it correct.
- 16E set marked stake on line to stone at S 1/4 7.
line short 11 chs of Govt meas R 39.54 act 39.48.
- set corner at 19.53½ 1289.31 and 19.44½ 1316.37

11-1892 Chas Fraser P500 no 471 sec 18 Davidson
found stone set by Mr J. Udell and mr Perrie Harney
in place of govt stake when stake was standing Perrie
-16S planted Boulder M&L 19.96¾ 1317.85 (over)

6-1893 Jas M Fraser P516 No 482 sec 13 M Fowler.
found stone P 500 left as found.
Meas south to stone set N & L 39.92 1/2 2635.05.

7-1933 Co H D B 73 P 19
stone corner in place no desc no reference.
Corner tied to extended tangent of road at that time
as it intersects N-S section line 755.4
at station 121 + 24.9 at angle 73° 15'
8-1-73 Walked to Corner with probe & shovel.
finally figured which fence was correct
No B Tree in hedge but hon Side found Lstone
on top rather short but could be corner

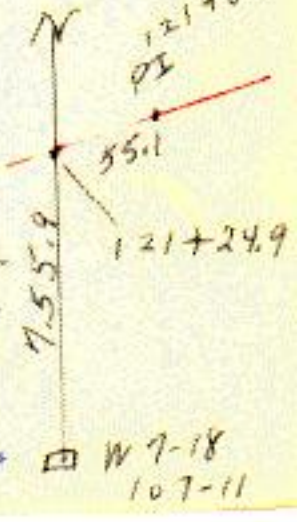

Gov't notes: Sept 1853 Set Post for Corner
Bars
Burr oak 8" N 44° W 25 links
Burr oak 12" S 36 1/2° E 243 "
Burr oak 11" N 87° E 243 "
Burr oak 8" S 63° W 80 links

#710705 (2)

Section Corner West 7-18 Quincy 107-11
East 12-13 Viola 107-12

11-8-76 Doubled line and measure from E 13-24 over E¼ 13. Point came on E side of corner post to fences N and W. Dug 3'x3' on E side of post and found the base of two old posts. Set ½" x 2' rebar in old post which later calc. .24 S and .22 W of exact double. Will not set final corner until 1/10th S is dug again