1 8-16-92 found boulder. set buggy axle on S side
6-11-79 Reset C.I.M. over a ½" x 12" rod after road grading. (1)

¼ corner West ¼ 7 Quincy 107-11 #7107706
East ¼ 12 Viola 107-12.

6-1877 Hunter P 317 No 311 L 7 H W Smith.
found stone in ground where ¼ corner claimed to be.
B trees gone


1300.04
1/16 East- set stake at 19.69 ¼ then 19.93 ¾ 1315.88
this ration derived from computed mean of north & south sides
short 12½ lks east to center
short 11 lks on south line actual SW 7 to S¼ 7.

Gov'T notes: Sept. 1853 - Set Qr. Sec. Cor.
B.t's Burr oak 10" N 25° E 266 links
Burr oak 12" S 66° W 378 "

(over

8-16-72 dug by hand on testimony of a McEvans and found boulder with 6"x8" round top quite long. set 3' long squarish buggy axle on S side of stone with glass etc. very little near to RP until grading done.

- set 3/4" x 3' rod with large square head about 8" north of high new woven wire fence West of corner 60.0' - set transit on □ bolt and sighted to north edge silo on farm on Co road # 2 about 1 mile away. Angle 27°52' on reverse transit to corner

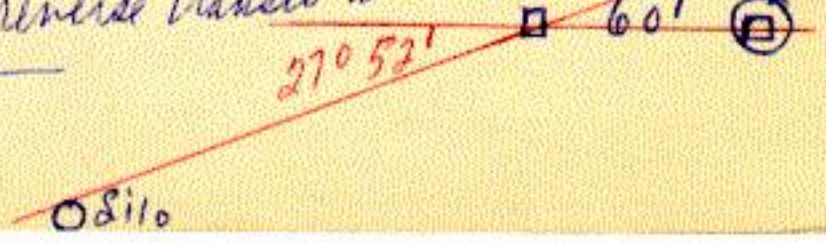

#710706 (2)

Card #2 West 1/4 7 Quincy 10 7-11
East 1/4 12 Viola 10 7-12

6-1902 Robt Frazer old fieldbook # [10] Page 44
Section 12 for H C Richardson
at "H" found boulder stone in center road.
and in line with fence running west.
"Ran D-H S 89½ E set stake on center 12
Mr Richardson said he would put stone.
No mear or use of any corners on Twsp line.
6-11-74 Reset C I M. over a ½" x 12"
iron rod & took additional R P's
(over)

Corner is in line with E - W Fences + in the ℄ of the trap road

Bridge bolt 8" North of Fence Running West	West 600
Punch hole So end 12" field drive C.MP.	S.E 38.08
" " " " " "	S W. 38.65
C.S Disc corner post (5" created)	E. 4280