/ 4-4-1973 found recorded limestone
placed 1¼" x 2' pipe on each side & piled
more limestones near. (1)

#711704

1/4 Corner 17-20 Quincy 107-11 Geo Smith.


11-1891 2 hor Fraser P459 no 443 S17 Geo Keyser Stoddard
found stone 4' long set by Mr Dowling and found
Marked stake by side.

6-1895 2 H Fraser P577 no 527 S 20 J A Watson.
found stone above P459.

1/16 each planted stone 3½ feet long M & L. 19.94½ (13/16.35

over.

11-1892. 2 hrs Fraser P 500 to 477 & 18 Dunbar
in setting 17-18-19-20 mark. corner found. P 459. Harvey.
Varria.

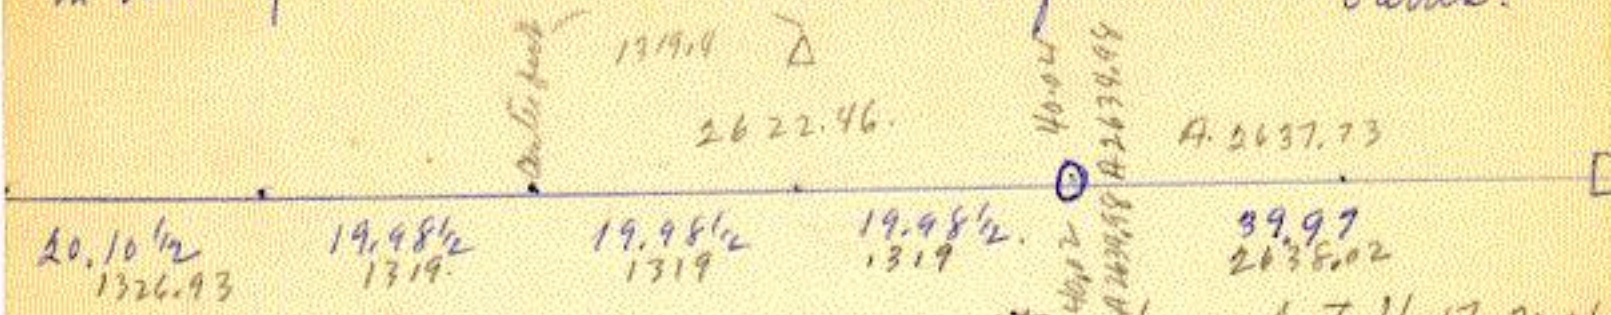

4-4-73. Meas west from recorded stone found at 16-17-20-21
found 1/16 stone as recorded P 577. fully 4"x 8" x very long.
at very near 1316. (was meas on. 10'± (S) south.
- cont meas west. easily found recorded limestone P 459
old field book states stone sticks 2' out of ground in each
area. stone now up 4" with top 2' lying on ground.
set 1¼" x 2' pipe just east of stone, placed long limestone
by corner to prevent washing away in floods see Card 2

#711704

(2)

Card # 2 1/4 17-20 Quincy 107-11

Corner lies on east side sharp narrow wash running NE lg to large main Canine running NW lg 29' NNW to center double blazed 24" burr oak 12.8 SSW to center double blazed easterly of 14" Twin oaks 10.4 NE to WB in 7" triple blazed hopfolder Meas east slightly less than recorded 1316.35 has perfect. did not check for line but set up 95 (S) north for E 1/2 Meas west on elect traverse. 2637.73 To random nail 2622.46 from corner post Concreted mat 1/4 18-19 midway as set in 11-1892 P500 by Thos Fraser 2630.1

over

This Fraser meas 1/4 18-19 and 1/4 17-20 5276.0
or 4' ± more per 1/4 mile
- example known points at N-S 1/16 line SE 1/4 18 1318.2
of which record 1321.0 on land going 2.8 more per 1/4
mile so Thomas deed measure so good 5.6 per 1/2 mile 1500
- later final meas 1/4 17-20 to 17-18-19-20 = 2628.77
R 2638.

GOV NOTES 1853 - Wm A JONES

SET 1/4 SECTION CORNER post mkd 40 chs 2640

FARM LINES N & S

COMMON LANDS E & W

CORNER IN high area mtns to steep slope to mtn ravine
NWLY NEAR 1/2 mile AWAY pretty rough country this LINE