/ 9-8-86 Set C.I.C./P² at stone location #711905 (1)


section Corner West 19-30 Quincy 107-11
East 24-25 Viola 107-12

5-1889 Thos Fraser P 431 No 418 $30 6 parties see SW 30
wild country, no fences in area. No B trees ever. A Mr Smitherburger once carried a stone to stake ~~set~~ to place at corner and it lay on ground. Original stake was soon found very rotted but plain in clay below. Settlers present agreed to location
set stone 2½ X 6-1 X 16.
1/16 east - set boulder 10 X 17 X 22. at 20.25 L then
19.95 L to N 1/4. This short 8 ¾ links. (found by county).

Gov't notes: Sept. 1853 Set Post for Corner
Bt's Burr oak 14" S12°W 70 links /// Burr oak 8" S77°E 62 links
Burr oak 10" N68°W 173 " /// Burr oak 12" N15°E 175 "

W SEC COR 19-30 QUINCY

9/4/86 DUG AT FENCE CORNER TO FENCES N-S-E, DUG 1½'N 1'+ So. 2' EAST, & 3' WEST

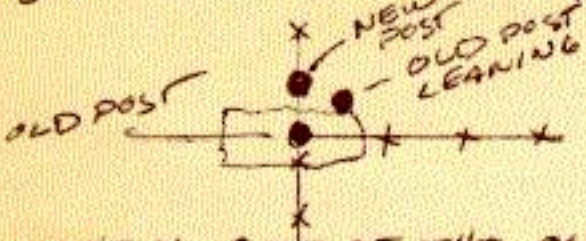

ON THE N. SIDE OF THE OLD POST HOLDING FENCE N-S-E AND DOWN 6" FD LIMESTONE 6" WIDE AT BOTTOM & 1" WIDE AT TOP TO POINT, BY 2½" THICK AND 14" LONG BUT IT WAS SET POINT DOWN AND HAD BEEN DISTURBED. DUG OUT STONE FOUND SEVERAL LIMESTONE PIECES, DOWN 1½' FD LIMESTONE STANDING 4½" X 1½" TOP & 4½" X 3½" BOTTOM by 16" Long THE TOP STONE WAS A FEW TENTHS WEST OF THE BOTTOM STONE, DUG FARTHER & FD A 15" LONG LIMESTONE WITH 6" BOTTOM & 1½" TOP (POINTED) CAVE. WIDTH 2½") LYING FLAT COULD FIND NO MARK WHERE IT MIGHT HAVE STOOD. THIS STONE APPROX 1' SE OF C.P. CLAY DOWN JUST 1' SO 1ST STONE WAS DUG DOWN VERY DEEP.

SEE #2

SEC COR WEST 19-30 QUINCY 107-11 #711905
9/8/06 EAST 24-25 VIOLA 107-12 (2)

DROVE TELSPAR/LIC AT LOCATION OF STONE OVER STONE FD. DUG ALL 3 STONES IN ON N SIDE OF TELSPAR. CORNER 1.0 N & .3 E OF OLD C.P. TO FENCES N-S-E & 1.7 SO OF NEW POST WITH SURVEY MARKER SIGN IN N-S FENCE LINE RPs C.S.D. IN E SIDE FENCE POST N. 1.66

1948 CHD FD STONE AT 1/16 east (Bk 146 p456)

6-1843 William Fraser (p514, No 481) found stone set by Thomas Hunter? measured north 74.85 chs ~~set~~ tempary point midway and on line.