
1/4 Corner 5 1/4 Cor Sec 33 Quincy 107-11
N 1/4 Cor Sec 4 Dover 100 11 (1)
5/19/89 SET 1" SQ PIPE/CAP #713304
Gov't notes Sept 1853
Set Post & drove chained stake built mound with a trench

10-14-83, N 1/4 Cor 4: Dug from the t.n. (set in ℄ E-W road and in line with the fence North), North for 6', East for 3', and West for 6' by 4' deep to clay. Found where someone had dug (probably 1938 CHD) From 1/2' North of the t.n. North for 6' (ie centered 3 1/2' N. of the t.n.) diggings only 1 1/2' wide at clay and in line with fence North. Condition poor on the N. side of the road - No real black soil at all. Condition a little better toward ℄ 1938 CHD Book 44 shows road fence split would be 7 1/2' N. of t.n (present ℄) and also that the fence South was 2' West of the fence North

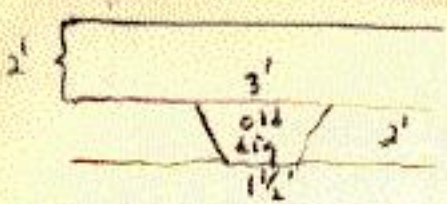

10-18-83, N. ¼ Cor 4: Dug 4' more off the South side of the hole dug 10-14-83 but found nothing further). Line from corner we have (NW 5 to RE 4) moved corner 2.7 South of T.M. Line from ¢ NW 4 to NE 4 corner .44 So. of T.M.

5/19/89 SET 1" SQ PIPE/CAP # 15809 BY LINE BETWEEN SEC CORNERS & IN LINE OF FENCE NORTH & FENCE LINES IN SEC 4 AT CENTER & 1/16TH NO. IT FALLS IN ¢ E-W CO RD. # 9 RP'S

C.S.D IN PP # 976 SOUTH 32.67
& FIELD DRIVE SOUTH EAST 10.0'

South 1/4 33 107-11 Quincy
North 1/4 4 106-11 Dover

(2)

#115504

June 1993 CHD Took grading ties to square Pipe w/Cap Before Construction of CSAH #9

12-10-93 CHD Set 3/4" Iron as Corner in Crushed Rock CSAH #9

11-29-94 CHD Set 3/4" Copper Rod in Concrete CSAH #9 as Final Corner