17-10-73 set 1/2" x 30" reinf rod Mag Check Set

#720204 ①


1/4 Corner 2-11 Viola 10 7-12

10-1889 J Fraser P436 No 423 L2 Interington, Johnson
set boulder 2' long N & L 39.87½. 2631.5
-1/16 west set stone about 2' long N & L 19.93½
1315.75

6-1893 H Fraser P518 No 484 L11 L. Purvis, C Richardson
found stone P436.
1312.81
-1/16 south set stone 2x6x20 N & L 19.88½ N22°E
to stone at center sec 11 2½x5x24

- 8-16-72 set nail in center road on line fences N & S.
Taped west to 1/16 fence N 1313.78 then 1315.85 to stone
R. 1315.75
(over

found at 2-3-10-11. in center road in line fence &
RP to nail used as line at 1/4 2-11 for measure west
47.85 NE to cone nail on NW side corner post.
40.18 SE " on NE " cedar post.
Random nail at 2-3-10-11 came .2 N of stone found
3 stones

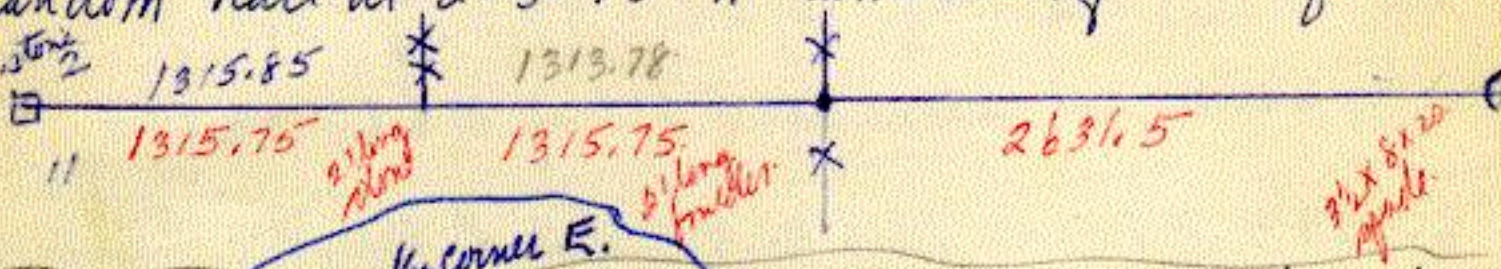

1/16 corner E.

6-29-73. found 4" □ L stone over 2' down all in clean clay. Indicating clay very shallow and road ran deep when stone set.
-set working prior to finding 1/4 2-11 or 1-2-11-12
set 20 D Sat edge road 9.75 nail W 30.0 (could get lost)
-dug entire area at 1/4 2-11. to clay which is old road top.
found working must reset on section line N&L or from south.

Card # 2. 1/4 2-11 Viola 10 7-12. #720204 (2)
7-9-73 after finding 1-2-11-12. 7-5-73 dug again
at 1/4 2-11 but road long gone to clay.
7-10 re meas S line sec 2. accepting line ran 7-9-73.
set 1/2" x 30" reinf rod exactly M & L 2630.45
Corner Comic in center road 2' east & fence north.
16.8 5'E & N to punch mark in rock top center 15" field calls 17.0
31.75 NE to punch hole in east end 15" calls slightly smashed
46.7 32.55 NE to cone nail in NW side corner post & fe E.
39.28 47.25 SE to cone nail on NE side Cor post & fe E.
did not set C/M as will check line & meas south
at later date. Changed rod due to error in Calculations
39.64
Gov't Notes - over

Cod't Notes W. A. Scott 1853
East Random between 2+11
40.00 set B temporary section post

West on true line between sect 2+11
bear S 8° 58' E
40.01½ set a section post in Mound of
Earth - Seal deposited charcoal, Mate
trench + pits planted Osage, Orange
Seal Nos of trench