1 6-22-73 found old stake or post 2 ole down 5'+ ①
7-5-73 set C I M over rump rod replacing 120 D.
section corner 4-5-8-9 Viola 109-12. #720405


12-18 73 Hunter P 236 No 238 S 5-6-7-8 L Holton.
found stake driven center road by Sawyer when org stood. corner
- Meas west 40.06 to org stake found.
26439.6

11-1891 L Fraser P 465 No 447 L 5 L Stunsberg
marked stone on plat likely placed by W Fraser 10-1894
a caption to above survey.
- 1/16 west marked stone M & L 20.04 3/4 same caption.
1323.14

10-1894 W Fraser P 553 No 510 L 4. E Dickerman.
found stake with stone by side P 236 owner)

- meas west 40.09½ to stake found & tested LEBT.
as L½5 set by T Fraser, reset with stone and stake.
2646.27

6-22-73. dug dep. 7' with charlie found old stake or post hole over 12" or more of it. very near where corner had to have been set wood post in hole and 720 D. as temp corner. Meas E very near final 2628
- Corner in center. road running E & W.
- " just E of fence " S very little.
132.6 W to ∠ RR tracks.
143.93 WSW to square bolt marked ∴ in near center most Northerly leaned span RR tie.
40.6 NE, 40.4 SE to edge of abutment footing. 3'+ below top main abutment.

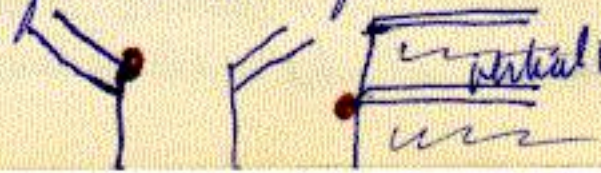

7-5-73 set CIM over rod

Cor' Notes W. A. Jones 1853 #720405 (2)

80.00 Set A cor section post + 4, 5, 8 + 9
in mound of earth And soil deposited
Charcoal Made trench and pitts planted
Osage Orange N.W. + S.E. of trench

Viola Section corner 4-5-8-9 (L)

Coord Notes on reverse side

8-1-96 Found CIM in good condition 14" Deep in crushed Rock road, 65th St NE 1½' So. of ℄ and 132.6' East of ℄ R.R. Tracks.