1 6-27-1973 set C/M over 1¼x2' pipe and orig. stone ① # 720505

section corner 5-6-7-8 Viola 107-12.

12-1873 Hunter P236 No 238 S 5-6-7-8 L Holton.

found a stake in a mound but as this area had been a cattle Corral and cattle had knocked stake down & flattened mound and when old stake was found & stacked up on a "hillock" of which there were many this corner was designated.

run line N W 5 over W¼5 on to S W cor 8 and W¼ 8.

" " N E Cor 8 over N¼ 8 on to N¼ 7 & N W 7.

set a fair and just corner making lines as near straight as possible etc - set stone 21x3x 3/14.

— meas North 40.00 chs 40.27

2640 2657.82 over)

Meas south	39.92	then	40.08	Note records
	2634.72		2645.28	hard to read on
Meas east	40.12	then	40.06	micro-film
	2647.92		2643.96	see book Abstract
Meas west	40.00	then	37.85	for details.
	2640		2498.10	

5-1886 Hunter P407 No 396 & 7 A Heyn, F Belitz.
found stone center road P. 236.
1/16 west set stone center road. 19.98½ N&L. 1319.01.
– Meas south 39.92. 2634.72.

11-1891 T Fraser P465 No 447 & 5 & Steinberg
corner not used at all in this survey, but caption of
10-94 of T Fraser shows corner used – set 3 stones east.
east 20.00 – stone then 20.00 stone & stake S¼ 5 Then stone 2004 3/4
then stone at & E cor 5. 1323.14.

Card 2 #720505 (2)

section corner 5-6-7-8 Viola 107-1.2

1930 Co H D B62. P7

found 4x4x18 limestone 4' deep. placed ½" pipe riser. Sta N'47 west 106+45.3. - Sta 131+92.5 2637.74 T 201.1 at N'47.


R.P. hub E 48.0 — Cor F.P. NE 39.1

6-27-73. dug with tractor. at random meas & line from east - there is no sign of occupational location. - found 4"x4" top limestone found by Co H.D. in 1930 and then last as far as location & use is concerned - set 1¼x2' pipe over stone with C/M over all.

over

Meas E to 1/16 stone found 1319.62.
(1/16 stone in center road 4 x 9 x 20 with wide fissure in top drove 3/8" iron into crack 4"+ sticking out.
124.5 WNW to Cor nail driven thru alum pole emblem 1964.
on S side PP # 20854 - stone on ⊕ side line of field drive south
RPs to 5-6-7-8.

Meas E 1 mile
2639.24 then
2644.06 to 4-5-8-9

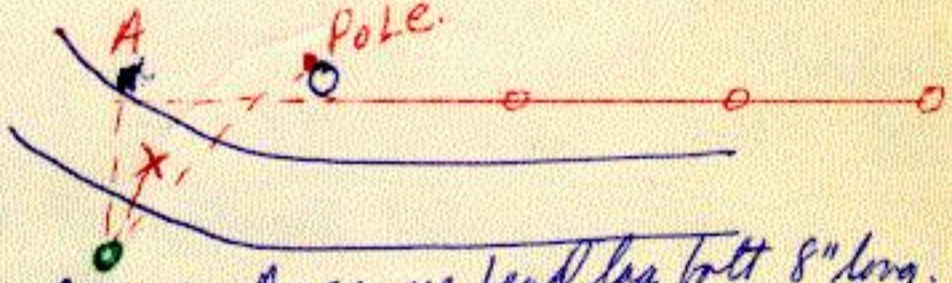

A square head lag bolt 8" long. aided in eye line pole Easterly
Cor to A. 34.35'
Cor to Pole 41.3. # 20858
Cor to X 23'± A to Pole 22.2.

Gov't Notes W. A. Jones 1853
Section Corner 5-6-7-8 #720505 (3)

$0.00 Set a section corner post to
Section 5, 6, 7 + 8 in Mound of Earth and
Seal, deposited charcoal Malt trees
and pipes planted Osage Orange Seed
N. W. + S. E. of trench

Viola Section corner 5-6-7-8 (3)

Gov't Notes on reverse side

7-30-96 Fd CIM in good condition 12" deep on ditch slope of 65th St NE on CURVE ℄ 65th St on curve NE 20½'