X 11-13-73 found stone, set nons on east and west
#720805 (1)

section corner 7-8-17-18 Viola 107-12.

6-1876 Hunter P298 no 293 D18 A Whiting, D Howard
found stone planted at fence corner, tested by B tree stumps.
- meas west 39.56 To N 1/4 18 then 38.20 to Twp line corner
2610.96 2521.2 N 89° 37 W.


5-1886 Hunter P408 no 397 D18 August Fratzke.
found stone set P407. below.
- meas south 39.93 due north 2635.38.
- meas west to undescribed 1/16 cor 19.78 1305.48. N 89 3/4° W.

5-1886 Hunter P407 no 396 D17 A Heyn, F Bethke etal
found stone P298 tested stump NW B Tree.
- meas ~~north~~ 46.08 to marked corner fence post in mound 2645.28 org)

11-1891 Chas Fraser P466 no 448 d18 L Hines.
found Hunters stone P408
- meas west 39.51 Then 19,76 and 18.41 fee 1/4 9/18.
2607.66. 1304.16 12 15.06.

5-1933 J Kerr B8 P97.
corner came 8.1' north of twin burr oak trees.
No desc. of corner or meas. from it.

11-13-73 found 4"x7" topped stone at least 2' long.
set irons on East and West sides.
Meas West 2602.41 R Hunter 2610.96 TF 2607.99
26.75 N to Center blazed 8" burr oak with bussel
36.15 NWly to 20 d LW side easterly of Twin
burr oaks lightly blazed.

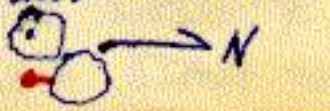

Viola Section corner 7-8-17-18 (2)

#720805

Govt Notes on reverse side

10-16-96 FOUND STONE 4x7x24 WITH IRONS ON E & W SIDES. PULLED STONE & SET CIC / 4' LONG FELSPAR PIPE IN ITS PLACE. THE CORNER FALLS ±3' NORTH OF FENCE WEST & 2½' WEST OF FENCE NORTH. SET SIGN & POST 2' SOUTH OF MON.

(1973) SPIKE TIE IN TWIN OAK NW 36.20

CSD IN BRACE POST SW 4.18

Gov't Notes W. A. Jones
North 17-18

[redacted]

80.00 Set a corner post to section 7, 8, 17, 18
Bur Oak 8 in N & W 15 & 1 lks
Bur Oak 8 in N 71 E 9 & 1 lks
Mark A tree