X 9-1-76 Set ½" x 2' rod over orig stone #721805 #1
12/7/89 CHD SET 5/8" BRASS PLUG

section corner. West 18-19 Viola 107-12
East 13-24 Haverhill 107-13

7-1874 Hunter P258 No 258 L19-30 John Nevins.
corner gone. found stump SWBT also NEBT hole
where stump grubbed out - SE & NW Blues gone.
set stone 4 x 5 x 14 at location Govt notes.
- meas west 39.82 to point set from BT stump. 2628.12
- meas south 39.96½ to stone 4x8x26 set M & L. 2637.69.

6-1876 Hunter P298 No 293 L18 AW Hickey D Howard.
found stone P258, broken & partly washed away
set new stone 4 x 5 x 27 in to place.

over)


– 1/16 east set stone 4 x 7 x 16. M & L 19.06 3/4 N 89° 45 W
this stone placed midway by instructions of owners SW 1/4 18
– Meas north 39.94 to stone set replacing stake.

1937 Co Hwy dept B 92. P 78.
found rocking set limestone 4 x 10 x 15 with cross.
Sp cor post – N 28.2 – + headwall culv SW 5 2 6.
Sp cor post SE 58.2 Hub north N 63.9 ? P.I. ?
later lies Rail on Tele pole SE 41.1 – Sp log Cor FP SW 45.9
set 1/3 meas W 1/4 18 to W 19-30 2636.93 and on direct tang line

---


9-1968 JKerr found stone at W 1/4 19. 2.4 N & 2.2 W of Co corner stone to SW 19 2638.7 if double meas wood corner 4' N and 4.4' W of where county set corner. either big kink in tang line at W 18-19 or SW cor 19 boulder not true corner. Corner of these very deep.
McGhee set rod (see survey sheet) 1958 April 1st

Section Corner W 18-19 Viola 107-12 #(2)
E 13-24 Haverhill 107-13 #721805

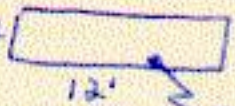8-25-76 Dug + 

from 5' E of McHlie rod W and from McHlie rod N.
Found C.H.D stone .21' N of rod and 6' deep (remark)
Found remaining 24" of Hunter's 4" x 5" x 27" stone (broken) 5.7' W and 3.5' N of rod and 7' deep.
Set C.H.D. stone (4" x 10" x 15" W.T. cons) on S side of Hunter's stone and reinforcing rod on E side
9-1-76 Set ½" x 24" rod. Corner 1' W ℄ road S and 1' N ℄ E-W road.
R.P.'s Punch hole top W. end of 24" C.M.P. to road S SW 35.91
Punch hole top S end of 36" C.M.P. to rd. E SE 48.10
CSD SE side of pp # 19409 NE 44.50

1/16 E (8-31-76) Dug with backhoe from a pt 2' W of traverse nail W. for 8' and N for 4' by 4½' deep to clay. Found old road on clay. Scrapped and found mark in clay apprx 4" x 4" as described by Hunter 1.1' N and 7.35' W of T.N.
Dug to corn M&L. See Dwg.

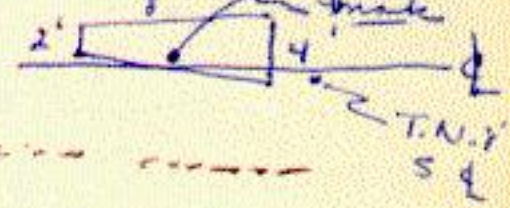

Gave Notes,
50.00 Set pins & guard stakes
18-18-19-24
B-Oak 10 N 65 W 185
B-Oak 12 S 88 W 185
B-Oak 10 S 8½ E 213
B-Oak 8 N 25 E 381

SECTION CORNER WEST 18-19 VIOLA 10T-12 (3)
EAST 13-24 HAVERHILL 10T-13

8/7/86 SET TRANSIT TIES 3/4" PIPE W/CAP WEST OF PP # 19431 IN ℄ OF TWP. RD SOUTH AS R.P. TO SEC. COR.; S.E. PROPERTY CORNER TO ROBERT P. SCHMIDT PROPERTY R.P. TO 3/4" PIPE CSD IN PP # 19431 EAST 28.47' ⊙ 3/4" PIPE ∡ RT 143° 07' 14" MOST NORTHERLY & SHORTEST RADIO TOWER IN SEC 26 10T-13 TO W. SEC COR 18-19 VIOLA 282.26'

#721805

8/11/86 REPLACED CIM WITH 1/2" ROD

12/7/89 CHD SET 5/8" BRASS PLUG IN ℄ C.R. #2
CHD DISC IN C.P. S.W. 69.59'
CHD DISC IN P.P. N.E. 76.86'
SPIKE & CHD DISC IN APPLE TREE NW 64.46'