X set 1/2 x 4 1/2' rod in old stake hole found #723304
11-30-1874 set a 1½" pipe as Final cor. in Conc. (1)

1/4 corner south 1/4 33 Viola 107-12.
north 1/4 4 Eyota 106-12.

5-1880 John Fraser, P364 no 355 & 33 E Derby etal
found cedar stake as at 1/2 mile west -
set flat stones as witnesses 50 lks north & south.
10 west set corner (likely M & L) no mear.

---

5-1903 C Armstrong P46B, & 4, A Randall etal.
found red cedar stake with stone beside it. in direct
line of fence north - 60 lks north & 52 lks south
rows of willows. left as found. used only for line &.
(over)

See 4 Survey by CA. - CA Field Bk #4 p113-114

9-1950 J Kerr. B3 P56.
found red cedar stake, set 2 x 12 x 18 limestone with glass etc.-
lines fences N & S. about 33' to rows willows on N & S sides.

---

Co H & D station 422+46.0 line fence south.
1968 J Kerr Meas from ℄ black top road north to Center 33 as set.
2626.64 set 1/16 point N'ly away for sight west only 1313.32

---

6-1970 Co surv. dug 2½' x 10' in black top centering fences N & S - proved fence line by setting 50' west several places along line south to center ℄ 4 where willow RP still in place fence line straight within less than 1'. - examined tops to willows in co tracks covered entire possible area. found no stones or red cedar stakes. Co grade near 3' to old road surface

see card 2

#723304 (2)


Card # 2 S 1/4 33 Viola

depth from old road surface (very hard, cinders gravel etc) to clean clay hardly 18". 9-1930 B 3 J Kerr would have to be in this road. finally found hole in clay and running up to within a few inches of old road surface at least 12" long very vertical filled with wood but not soked enough to left out no dirt or foreign stuff in hole. this came 1.25' west and 1.8' north of rod set as corner in center road.

RP stake hole with 1/2 x 4'+ smooth rod up to surface as true corner until proven otherwise by digging entire road up.

| | | |
|---|---|---|
| -40 D in butt E side Maple in fence South | 113.15 (not found) | Error 111.32 |
| - North edge heavy angle post set in concrete | 36.2 | 34.37 |
| - ground wire on E side Trans pp # 245 near ground N | | 145.24 Corr |

SW cor projection of porch (part of house) NW 113.5
little rod

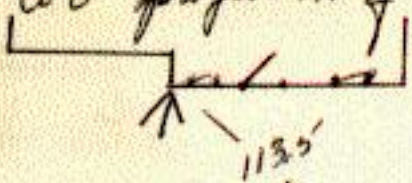


Co disce - W gate post NW 45.3
tele pole. N 31.77 little rod
PP 5' W of S 34.24

7-20-73 found Co rod and 3/8" rod over stake found in 6-1970 dug away entire road with 12' wide dozer blade. found exact corner as described by J Kerr in survey 9-1930 Book 3 Page 56 when stone 2x12x18 glass & broken stone some likely set when Chas Armstrong found cedar stake in 5-1903 P 46 B book. stone found within 1 foot of where dug in 6-1970.

S 1/4 33 Viola 107-12 N 1/4 4 Eyota 106-12 (3)
#723304
set small iron & more glass etc by corner. road
will be cut considerable in area. By new road.
final ties to new corner complete. 7-20-73
67.84 due S nearly to county disc W side PP # 42508.
143.77 N to Ground wire near ground level
on west side power pole in yard # 245
113.05 NW to SW corner (wood corner not conc fnd.)
of house projection like porch.
78.0 NW to new wood stub pole by metal tele
cable box. conc nail NE side.
114.62 fog nail in hub on E side maple tree complex.
(over) South

11-20-1974 Co. Surv.

Set a 1¼" pipe as final cor. in New C.R.# 9 cor.
Corner falls 0.65' E. of C.H.D P.I. + 1.45 North.
took no additional R.P.'s
corner falls in line of the fence North.

C.A. field #4 of A.A. Books p. 113-114 Sec 4 Survey
Says found ¼ Stone at 2644 from 3-4-33-34

Gore Notes
No. 00 Set pipe & drive thru stake for
gore corner corner B.L. mound with brick
Planted D.E Plum 6, N.E. Apple trees.