7-16-73 found Lstone, glass, brg axle shaft. #723404
11-20-1974 Set a 1½" p.pl as Sixth corner in Conc.

¼ Corner. south ¼ 34 Viola 107-12.
north ¼ 3 Eyota 106-12.


No known records County & State assumed data Conflict.

7-16-73 removed entire road area with D8 Cat & road contractor. easily found limestone (broken by dozer blade, glass and heavy axle shaft. at least 30" long X 1⅜"± dia referenced and replaced shaft in its hole where torn out by dozer.

- Meas from N-S fence at S 34-~~34~~ 35 as .00, found ⅛ fence south at 1325'+ and S 42 at 2603'+

over.

1973 R.P.'s

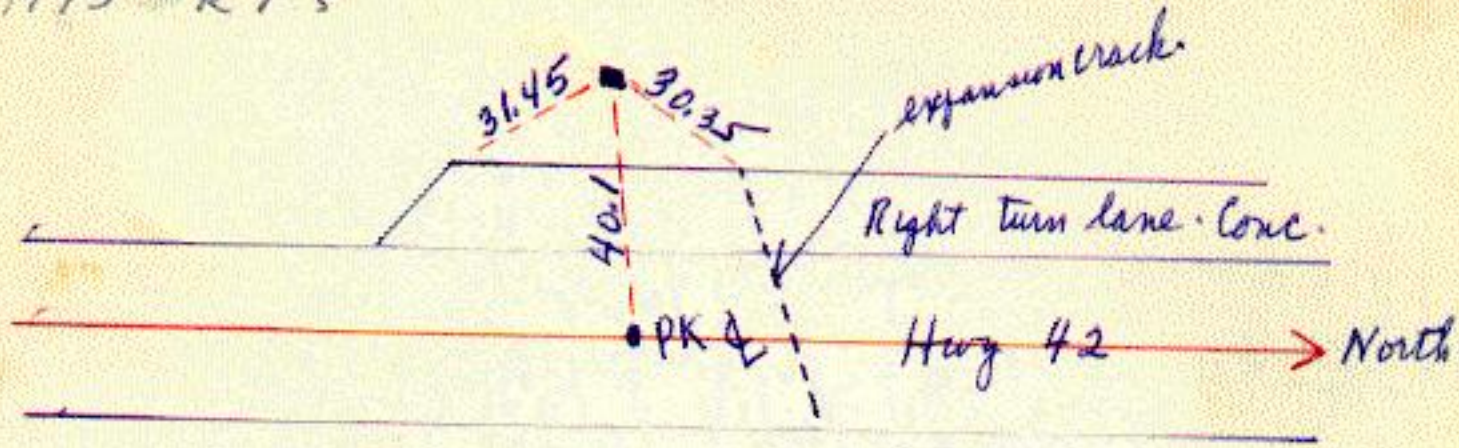

11-20-1974

Drove a 1¼" pipe as final corner on the conc. corner falls 1.95' South ℄ of C.R. # 9

C Sure disc West side of P.P. # 4.493 55.N. 69.75

Good Marks

No. on Sec post & Sure disc bent over 7 marks around & stuck.