/ 7-16-76 CIM

#723505 (1)

section corner south 34-35 Viola 107-12
north 2-3 Eyota 106-12.
6-1874. Hunter P247 no 248 S 2 P Brockway.
found stone set in center road as sec corner.
- meas to SW cor 2 80.13 to be divided.
40.12 - 40.01 by govt prop. overran 24 lks.
Co HD station 501+68 - equator at (42) 1.85'

7-14-76 Dug with backhoe. Found 4" x 6" x 20" limestone 4½' deep. Set lawnmower blade on N and S side of stone. Stone .4 N and .76 W of traverse nail.


7-16-76 Set CIM over 1"x24" pipe all over stone. Corner falls 1' W of fence line S. and in line of fence North and 3' South of ℄ of C.R. #9

R.P.'s CSD in pp #337 SE 52.41
CSD in P.P. N 36.60

Punch hole in top center of S. end of 24" concrete culvert SW 65.29

Punch hole in top center of N. end of 24" concrete culvert NW 66.63

1/16E (7-15-76) Dug with backhoe. Found 3"x5" black mark with small piece of limestone in clay 3' deep. Mark .15 N and 2' E of traverse nail.

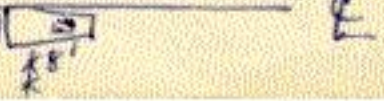

Section corner South 34-35 Viola 107-12
North 2-3 Eyota 106-12 (2)
#723505

Govt Notes
Stone Set pits & [illegible]

5-21-93 Took grading ties before Construction of CSAH #9

12-9-93 C.H.D. set 5/8" rerod @ Corner location in Crushed Rock CSAH #9

11-29-94 CHD Set 3/4" Copper Rod in Concrete CSAH #9 as final Corner