/ 9-24-76 CIM #730504 (1)

1/4 Corner 5-8 Haverhill 107-13

3-1898 H Fraser P 620 No 563 & 5 H Hendrickson Durlder N Mich

Corner post owned by Mr Simmonds.

he claims he set post in place of stake


- set stone 3x6x14 beside post & marked stake.

no meas on 1/16 corners

9-24-76 Dug with backhoe. Found stake with ax marks plain 6' deep along side of fence post beneath two older fence posts. Set 2" x 40" pipe with steel fence post in stake hole. Set CIM over a 3/4" x 22" pipe over the 2" pipe (Remove stake to office)

Cont Notes Over

Dug

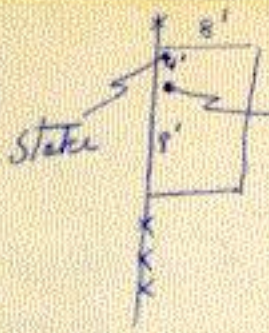

. Corner under N-S fence

R.P.'s: ∴ Mark SSW side (up 15") stave Silo NW 108.82

∴ Mark NE side (up 15") stave Silo NW 107.88

Spike and CSD NW side 5½' Cottonwood along side ditch ENE 85.20

Gov't Notes W.B. 1/c by 1953 East Ran. bm 548 40.00 Sta A temp Sta post West on true line between Sta 548 & 549 40.03½ Sta A station post

Bur Oak 8" in N 50 W 27½ links

Bur Oak 12" in S 25 E 21.3 links

1/4 CORNER 5-8 HAVERHILL 107-13 (2)
11/13/89 FD CIM IN GOOD COND. WITH TWO STEEL FENCE POST AROUND. PULLED ONE POST, SET SIGN & POST 1.0' SOUTH
#730504