X 3/28/90 Shot 2" Iron Shaft up 4'. #730605 (1)

Section Corner West 6-7 Haver. 107-13

East 1-12 Casc. 107-14.

1-1899 R Fraser P645 No 581 L12. Geo. Viken found stake with broken stones by its side, set new stake.

1-1900 R Fraser P646 No 582. L1-2-11-12. 15 parties found stake and broken stones P645.


- Meas west 39.94 3/8.
- Meas south 39.88 1/2.

3-1902 W Fraser P32B L12. Baker, Greenwood. found corner as described P645 & 646. -over-

-16 west set temp: stake M & L 19.97.
-16 center NE 1/4 12 set stake M & L 19.87 on N-S 1/16 line

Corner now 2" iron shaft in Concrete pillar.
used by state and other surveyors.
- Meas north from fence corner at E 1/4 12, 2627.3

R 2632.4

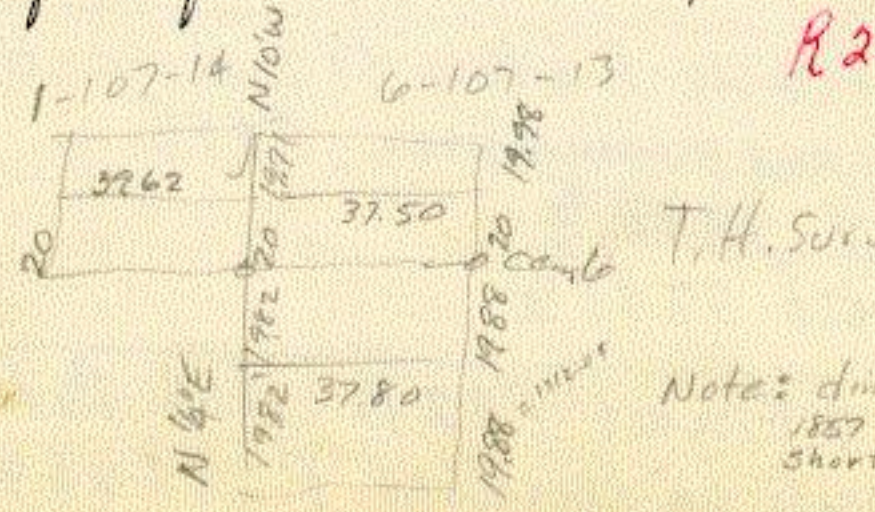

Section corner West 6-7 Haverhill 107-13 (2)
East 1-12 Costello 107-14 #730605

30.00 Set pipe corner to Section 1-6-7-12
B.- Oak 10 N 0° W 12
B.- Oak 17 S 10° W 450
B.- Oak 10 N 60° E 66

Dug East

3/28/90 Shot 2" Iron shaft up 4' as corner.
RP's N.W. cor utility shed E 12.8'
S.W cor utility shed SE 17.4'
there is a wood rail fence running south
& wire fence North for ± 50' & a stub
fence east ± 50'