7 11-21-1969 set CIM over ¾" iron in field - 12" dup. pieces bury stones around (1)

#731101

¼ corner. 10-11 Haverhill 10N-13

5-18 72 Hunter P201 No 210 & 10 @ Bailey M Casey. J Coyle & others dug extensively could not find corner.

Run N-S line set stone 4x6x20 Midway 39.94.

-16 North set stake M & L 19.97.

---

above survey states " corner missing could not find by digging Ran direct line A to B and set ¼ post at H midway between A & B set stone at H 4x6x20

-over-

7-1902. 2t Fraser. P22B S11. O Pike, P Staly.
found stone set as corner P201 but stone
although midway was 22½ links (14.85')
too far west to be on direct line. (very unusual).
-16 north set stone M & L 19.99 found 9-16-69
-16 south " " " " found 9-15-69
-16 east " " " 20.02½.

9-16-69. Meas line from C1N set as C1W11 north set nail at 1320 and nail in small cherry at 2644.07 - found stone at 1318.2 just .6' west of woven wire - set 3"x3' east and pipe with stone on south side and small piece concrete on N side with glass. Run 13' @ west and dug 6'x10' at least to clay for "4 corner found. 2 stakes with rag on may not pertain to corner. - found 1/16 stone north easily on east side corner post. will meas later.

see card #2.

#731106 (2)

Card # 2. 1/4 corner 10-11 - Haverhill 107-13.
11-17-69. Meas and run line from NW cor 11 south.
40° no wind warm. for Nov., found 1/16 stone south at 1319.9
- found 1/4 stone in corn row & field east at 1320.0
Missed 1/16 stone 6.6' 1/4 stone 13.85 Making 1/16 stone
.32 too far west or about east edge of stone.
summary of line -

			10-11				
SE 10		1/16		1/4		1/16	NE 10
	1318.2		1320.8		1320.0		1319.9

stone found 6' south of fence running west
" " 8.5 east of " " " north main line
" " 4.5 east of main fence " south.


(OVER)

11-21-69. set C/M. in place stone stub vertical but in 3 pieces which together made 4x6x20 also bottom of a wood stake. Corner comes east in field.

RPS - center 4" pine about 8' tall just west of fence line south. 6' west of south. 43.8.

- center 4" cherry in fence running West 6' north of West. 17.45.

11-21 & 24-1969 completed meas and line east taking C/M at 10-11 at 20.5 ⑤ south and center corner fence post at fence running west on west side of road. at similar 20.5 ⑤ south.

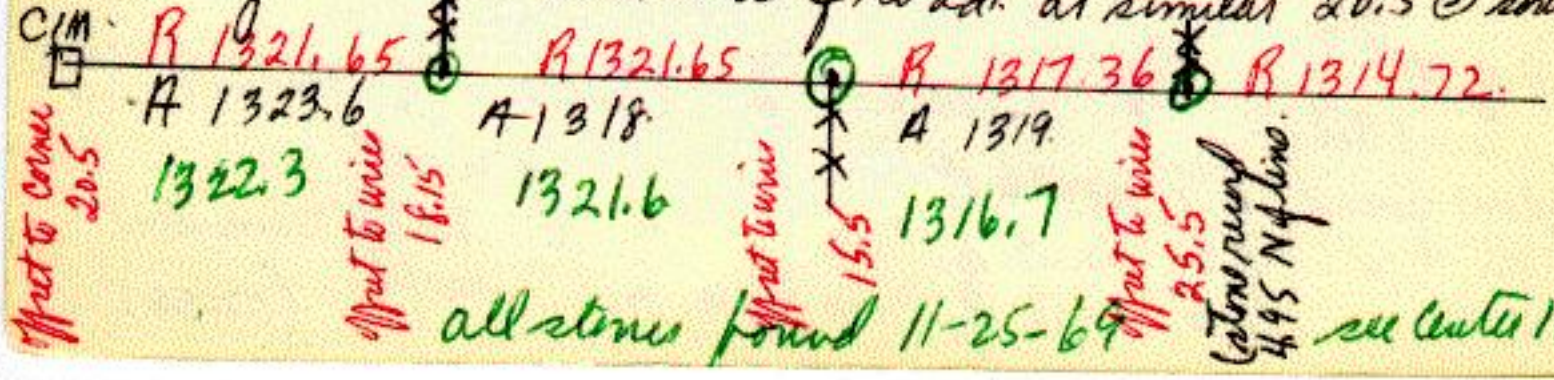

Haver Hill 1/4 corner 10-11

Look West on corner side

#731106 (3)

Govt Notes W.B. Verby 1853

40.00 Std A Std. post

Blk. Oak Gin 53. E 57 Iks

Malt A Irish