1 - Corner lost Completely. #731205 #1

section corner. 11-12-13-14 Haverhill 107-13

6-1857 J. Fellows. P 29 No 45.

used corner.


- Meas west 39.55

- Meas south 40.00

9-2-1969 J Kerr. Meas north from SE corner. 14. found farm boundry fence running west at 2639.2 which is only N boundry state lands not necessarily correct or very old. found old farm boundry fence east at 39.5' accepted as correct for grading road west. NE corner 14 in 3 foot cut on west side with no fence, common land. absolately no way of gpe replacing corner by existing lines ac 1/4 11-12 in deep cut, also (over)

total meas for 1½ miles. 7893.7 which considering
meas from SW 11 south as 2627.3 accepted ⅛ fence east of
3951 as correct - will find ¼ 11-14 if possible later.
NE corner 14 (this card) hopelessly and completely lost.

11-28-69. found W¼ 11, center 11, and both ⅛ stones on line, also ¼ 11-14
replaced. ¼ 11-12 with CIM - exact line fence as recorded
Corner could be replaced as follows - corner could be set 2626.8 CIM

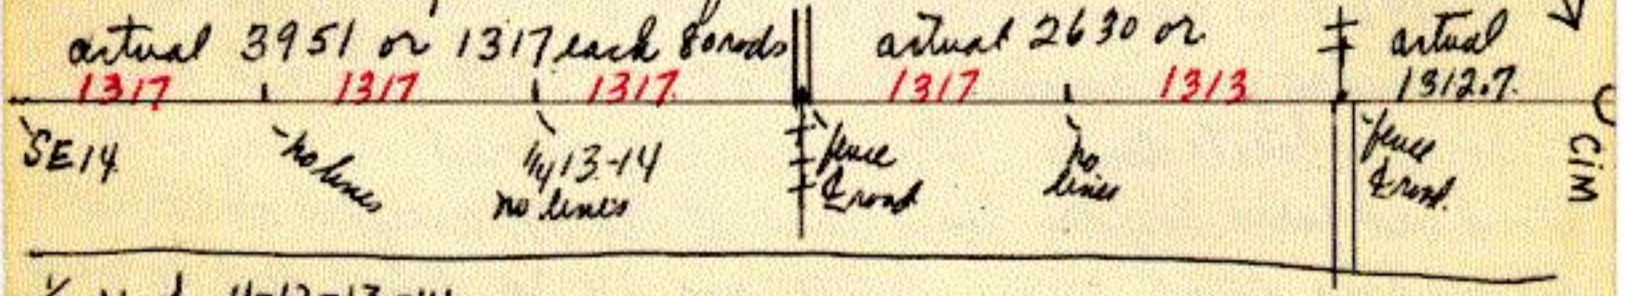

⅛ N of 11-12-13-14
6-18-76 dug from traverse nail W. to center of road and from approx 2' N. of fence line W. south. Road cut at 3' depth. Found nothing. S[illegible]

#731205 #2

Section Corner 11-12-13-14 Havahill 107-13

6-17-76 Dug with backhoe from ℄ N-S road W and over line of fence E. Found nothing

9-2-76 Set CIM over ½" x 2' rod by double proportionate measure ¼ Cor 13-14 to ¼ Cor 11-12 and ¼ Cor 11-14 to ¼ Cor 12-13. Corner came 2' E of ℄ N-S road (along E edge of digging) and 4' N of fence line E.

R.P.'s CSD E side pp # 195-79 SW 139.43

CSD in conc post ESE 30.85

Coord Notes on reverse side

Govt W.B. 1/4 by 1853

80.00 Stl A ~~trap~~ Stnd. cor. post to 11, 12, 13 & 14

Bur Oak 10 in N 43 W 439 lks

Bur Oak 10 in N 38 E 2011 lks

Bur Oak 10 in S 68 W 326 lks

Mark A trench

10-8-96 FOUND CIM 11" DEEP IN N-S TWP ROAD ± 4' NORTH OF FENCE EAST + ±3' EAST OF ℄.