/ 11-28-69 Set C/N over iron by line & mens from west
#731206 (1)

1/4 Corner 11-12 Haverhill 109-13

7-1902 Jr Fraser P22B & 11 @ Pike, P Daly.

Corner gone. found NE BT standing and
stump of NW BT


reset corner with stake & stone 3 x 8 x 14

this corner which came in line of fence west
-/16W found stone of unknown vintage as 1/16 corner.
- this corner 19.92 (13,14,72) west of above 1/4 corner then 19.96 to (13,7,36)
center 11

this corner also found to be 7½ like (4.95' North of direct line

(over)

11-25-1969 and 9-1969. Meas and run E-W ¼ line set points to hold chainage. on 11-25 found stones at center 11 and both 1/16 corners on E-W line. the 1/16 stone west of ¼ 11-12 lies 1.5' south south edge corner post - 1"x14" rod rises on stone a nail 4.95' south is on exact main E-W ¼ line as recorded - also 120 D on hilltop 200'± east 6.9' south corner of E-W fence south side of turn oak. this 120 to be used to project line east to set ¼ 11-12 E-W ¼ line as follows

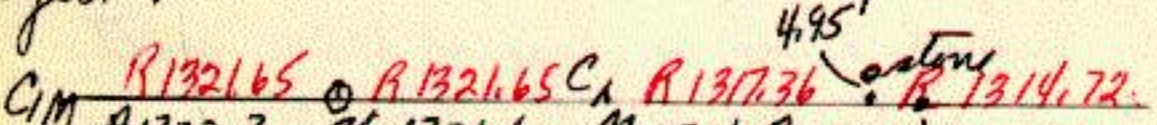

meas east to ¼ 11-12 should be about 1314.0 corner gone

meas from 1/16 stone east to east edge C post 3.5' & ¼ cor post 12 77.87 in 9/1969

meas from ¼ E cor 14 to fence west 7893.7.

#731206 (2)

Card # 2 1/4 11-12 Haverhill 107-13.

9-2-69 meas from SE cor 14 north. found north line boyce farm at 26 39.2. set in common land. also common on east side no evidence of proof of line
found reliable property fence at 1/16 north 1/4 13-14 running east near center road west at 3951 - 9' short full meas.
no lines at all at SE corner 11
fence line west in common land lining with center private drive east 2630' north of above fence last. then 1312.7 north to line fence west at 1/4 11-12 see 11-12-13-14.
11-28-69. set C/M over 3/4"x12" steel re-bar and muck glass. run east line W 1/4 11 over center and projected line east (over)

found line mixed center 1/16 stone east of center 5.15' instead of 4.95 coming .22' south 120 D set 1' south first oak in fence line on hilltop east. found meas center to center 1/16 stone 1316.7 R 1317.36 so set C/M at 1314' east of 1/16 stone R 1314.72 which helps bring corner closer to center road.
corner lies 5'± east center road 3'± from east edge road in exact line fence west as recorded.
- pipe cap N side cor post W 36.93
- Pk near bottom S side power pole # 19598 NNE 32.0
- center 30" white oak in yard easterly 57.0
Govt Notes W.B. 1st by 1853
40.00 Set A stone post
Bur Oak 21 ins N 78 W 50 lks
Bur Oak 10 ins N 50 E 57 lks