/ 8-13-76 Set CIM #731306 #1

¼ corner 13-14. Haverhill. 107-13.

6-1857. ~~Hardin~~ John Fellows NE¼ 14. P29 No 45


used corner.

- Meas north 40.00
- Meas west 39.76.

a parcel of land 22.5 acres owned by State of Minn lies to NE corner at this corner. at present day.

9-2-69 Meas north from SE cor 14 (℄ Bloop & B tree. found north boundry at ghost boys site at 2639.2 which proves nothing, common land both sides evidently came up ½ mile. meas to old property fence west 395'. or dividing up 1317.0 each 80 rods - no corner at NE 14 at all (over)

If extended another 1317.0' then next half mile to CIM set would be 2625.7 - as center farm road east and old fence west comes at 1313.± This seems to be the pattern to follow.

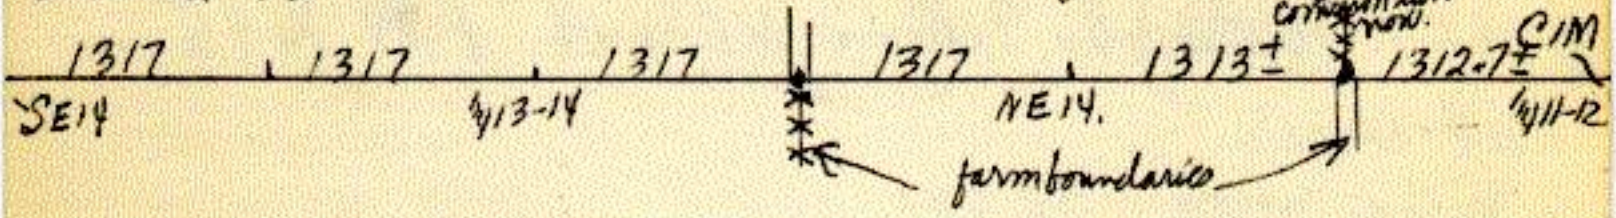

10-11-1881 T. Hunter Bk. 5 p. 117 unrecorded Survey sec. 13 apparently used something at this 1/4 cor. as meas. South is 40.00 ch. (13.33⅓ then 26.66⅔ To S.W. 13-)

Note: Line was run from 13.33⅓ ch. So. of ¼ Cor. To point 13.30 ch. So. of E.¼ 13. (this Could be prop. line Today)


8-13-76 Dug out most of center of road in line of fence E. Found about 6" of stake extending into clay

9-1-76 Set CIM. over ½" x 2' rod over stake. Collar in line of fence W and in ℄ N-S road

¼ Corner 13-14 Haverhill 107-13 #2
#731306

R.P.'s CSD NE side pp # 19562 NW 90.22
CSD telephone pole (NE side) SE 61.31
SE corner of 6'x8' concrete block bldg SW 60.12

1/16th Natl 6-17-76 Dug on line from Sec Cor 13-14-23-24 over stake found at ¼ Cor 13-14 and in line of fence E. Found road cut at 3' depth found nothing.

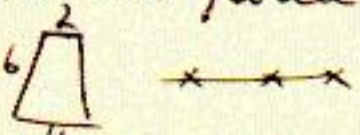

Gov't Notes W. B. 4/rr by 1953
40.00 Std A Std. post
Bur Oak 9.in S 72 E 200 lks
Bur Oak 10.in S 51½ W 182 lks

10-8-96 FOUND CIM .6" DEEP IN N-S TWP ROAD ±1' E OF ℄