9-17-1965 set C/M on bed rock on line ①
M & L. 2614.5 nothing below. #731506

1/4 corner 15-16 Haverhill 107-13

No records.

set corner M & L on section line 2614.5.

- Transit tie North and south 55.0.
- Elec in transmission power line pole. S 55.0.
- line of poles north & south comes 4.5' west of corner easting & westing.
- rod set as property corner by McGhie? ~~S 21.7'~~ possibly mrsd To Rainbow Inn

Gov't notes: W.M. B. Yerby Nov. 1853
10.00 chs set Gr. Sec. post
B.T.s Br. oak 12" N 14° E 53 lks.
Br. oak 8" S 20° W 73 lks.

33.00 chs. a spring brook Course S.E.

77.50 a stream 5 lks wide Course W.

10-1887 T.H. (Armstrong BK, Page 39 (Hunter's Misc Rd surveys)
Measured from Center 15 to W 1/4 Cor 16. Mean. 39.80 from Center 15 to W 1/4 15
Measured 40.15 from Center 16 to W 1/4 Cor 16.
1980 T.H. (same BK, Page 24) measured 39.75' from Center 15 to W 1/4 Cor 15

8-28-1985 RWB - Visited this Corner site - found CIM ± 3' south of ℄ E-W Road
9-4-85 Shot corner from Center 15
9-4-85. 1/4 Cor 15-16: Road in cut. Only chance along south edge. Dug from 8' to 12' South of Rein CIM by 4'+ East and 4' West. Road went right into bedrock

8-17-1965

RECORDED

LOCATED S ¼ CORNER SECTION IS BY R.P.S.
CHAINED NORTH TO APPARENT CENTER OF SEC
2639.62, CONTINUED N. TO N. ¼, IN LINE OF
FENCE TO WEST DIST MILE. 52.53.3 —
AT E ¼ COR SEC 15 FOUND 3" PIPE STONES SET C.I.14
STAKED LINE W FROM E ¼ COR OF 15

0	1317.3	OPP. ¼ COR
	382.	
0	1699.3	OFF N 2.5'
	200	
0	1899.3	1899.3
	764.7	734.3
	2664.0	2633.6 APPROX CENTROAD N. 5.33
0	3430.81	N. 6.97
0	4600.0	N. 9.32
0	5160.0	N. 10.46
0	5255.0	NEAR N+S FENCE LINES
		21.7 N of PIPE SET AS PROP CORNER


N.S LINE W LINE SEC 15

O.S.W.107 0	688.52	
0	1400.0	
0	2100.	
0	2582	S. 32.5 + 8.9 EAST
	62	
	2649	
0	3228.25	
	5229.0	TOTAL LINEFELL 7.6 N of Cor

10 1/2 / 1/3 / 10

HAVERHILL TWP. ROAD 45

1/4 LINE SEC. 15 - 107 - 13

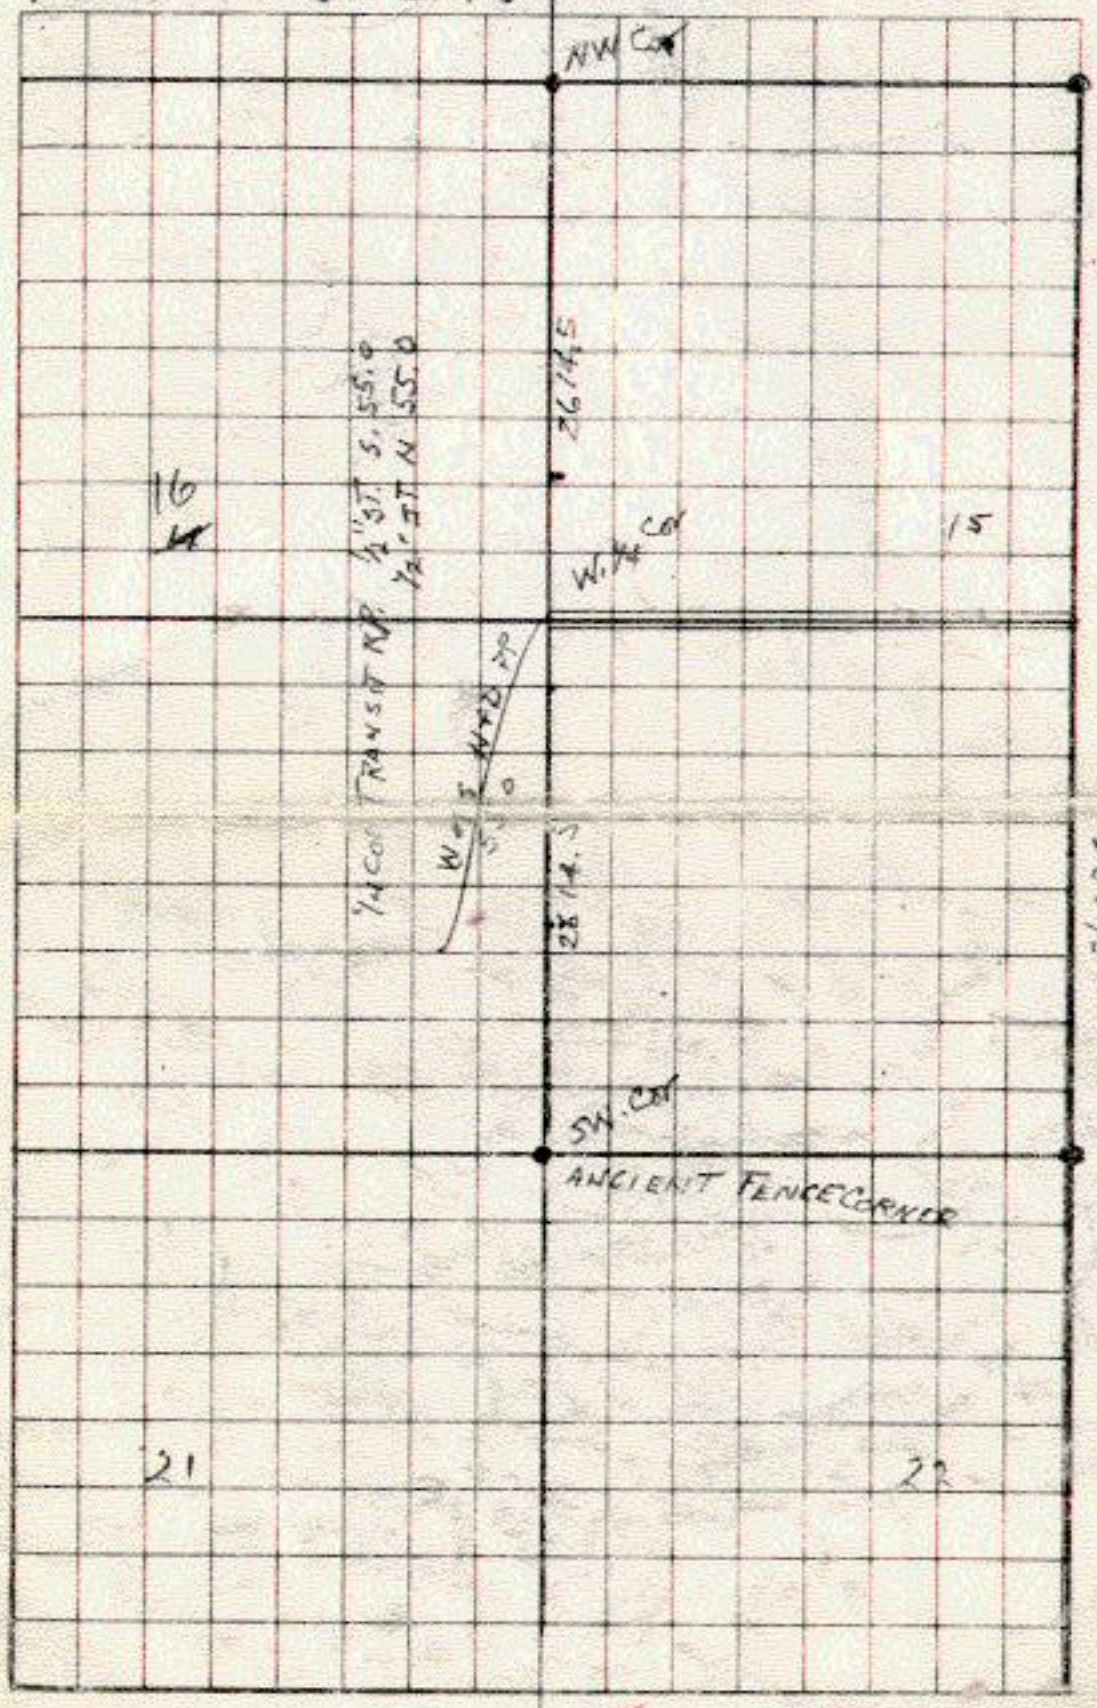

Kerr Bk 90

9-4-85, 1/4 Cr 15-16 cont.: and then into bedrock. Also dug from a point 21.7 South of CIM for 1½' North, 1½' South, 3½' East and 3½' West for pipe (a rod) referred to by Pat on Card. This fell in bottom of South ditch. There was a little clay left here but no pipe mark. Fd a ½" re-rod 32.24 South of the CIM (approx 3' SE of Dame Refuge Sign). This is probably the point mentioned on the card but measure (21.7) would have been to random line East.

10/2/89 FD CIM Rp's
45.83' SW TO CSD IN PP # Q6094
55.08' SOUTH TO CSD IN PP # 24222

Aug 1996 Dean Strange of People's Coop
found CIM, About 1' Deep.