#731806 (1)

6-22-1964 set C/M over 1" x 12" page
9-83 1" og pipe 713p184 Set 10" C.M.

¼ corner west ¼ 18 Haverhill 107-13.
east ¼ 13 Cascade 107-14.

8-1871 Perry by Hunter P187 No 198 L18 M S Higbee
all B trees gone & grubbed., by digging carefully
found. hole where old stake stood, set new stake
-16 North set stake M & L 20.08.

Caption 11-1888 Hunter same page.
found stake with iron rod driven by its side.


2-1878 Hunter P330 No 324 L 13 O Brooks & Others
- over -

found stake in center road set P187.
- meas west. 39.83

Corner found & maintained, 3/4" x 4' pipe set as corner.
6-1964. set C/M over 1" x 12" pipe as corner.
Disc tel cable guard pole. NE 75.5.
Spud tel pole. WNW 139.66.
Disc power pole. ESE 1264.
NW corner garage on house. SE 143.63.
4-78 Received survey data from M.H.D. Filed in "Blue Book"
at Center 13. Survey tie coord. on all corners (except SE)
in Section 13 plus Center 18.
Cascade
Mea. W 2616.14 to rebar
Mea N 2648.41 to CJM
Mea E 2565.90 to CIM

1/4 Corner West 1/4 18 Haverhill 107-13 (2)
East 1/4 13 Cascade 107-14
#731806

8-11-1980 ✓ Removed C.I.M. and found a 3/4" x 11" rod beneath. Left iron in place. The old road was on sand subsoil 1.7 deep. The C.I.M. was 3' East of the fence South. Dug from the CIM 3' North, 4' South, 4½' East and 7'+ West. Found nothing. We were digging to cover Perry's (Hunter) full measure from NW 18 and Perry's (Hunter) measure from the Center 18 (which would come appx 1½' West of the CIM). Found that someone had dug here centered 4½' West and 6' North of the CIM. They had dug about 3' x 3'.

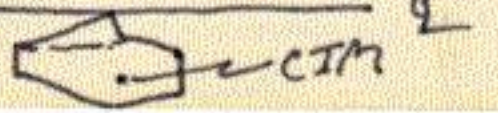

8-12-1980 ✓ W¼ 18: Took additional references:
CSD in large pp. NW 58.51 51.67
NE corner of house Fdtn. just below siding SE 176.25
⅝" rod under fence South and ± 13' West of a
9" poplar tree So. 80.51 80.48

See Notes ✓

No. Dak. ... pine ... pine ...
B. Oak ... W 75 ... W ... 15
B. Oak ... W ... E ...

102.10
74.17
176.27

9-1983 ✓, W¼ 18: Reset this corner after road construction with a 1"x15" sq. rivit cap about 7" deep
Reference: Set a 1½"x30" pipe pipe on line between W¼ 18 and the NE Cor of the block Fdtn of house. 1" sq in 74.17 SE of ¼ cor and 2½' South of a pine tree.

#731806 (3)

¼ Corner West ¼ Cr 18, Haverhill, 107-13
East ¼ Cr 13, Cascade, 107-14

7-30-84, W¼ Cr 18: Set a 10" CIM in new bit on C.R. 124 over 1" sq. pipe with cap set 9-1983. Checked against transit tie taken 9-1983 and R.P.'s taken 8-12-1980. The disc in pp NW58.51 did not fit now measuring 58.65 but all others fit O.K. and measure N. to C.R. 124 alignment checked (6.99) Disc on pp well around to West side so pp. may have been disturbed in construction. Removed C.S.D
New R.P.: P.K. in NE side pp Q6044 (up 2')
NW 58.24