/ 5-22-77 Set CIM
7/6/89 Set Circ. 1p²

#731904 Card #1

1/4 corner 19-30 Haverhill 107-13.

4-1872 Hunter P196 No 206. S19 O. H Holcomb found orig. stake standing at fence corner.

- Mear east 40.30 (2659.8 S 88°55'E
- Mear north 39.66. (2617.56 N 3/4° E


9-1891 Chas Fraser P456 No 440 S30 John Holo. used fence corner & fence south as party wasnt particular about exact west bone - orig corner once at Flor.

5-1894 Wm Fraser captain above. found stake in survey for road 7-13-1894. left as found.

-over-

12-3-1900 2nd Fraser P700 No 616 S 30 107-13
E½ S 25 107-14
found remains of old stake under
NE edge boxelder tree in line N-S fence. Geo Weber
drove new stake in its place.
- meas north 39.70 (2620.2
- meas west - 18.00 then 7.50 then 12.68 (38.18).
(1188.0' (495.0' (836.88 (2519.88

1-31-73 found above survey in old field book in detail
Field Book #9 p. 83-89

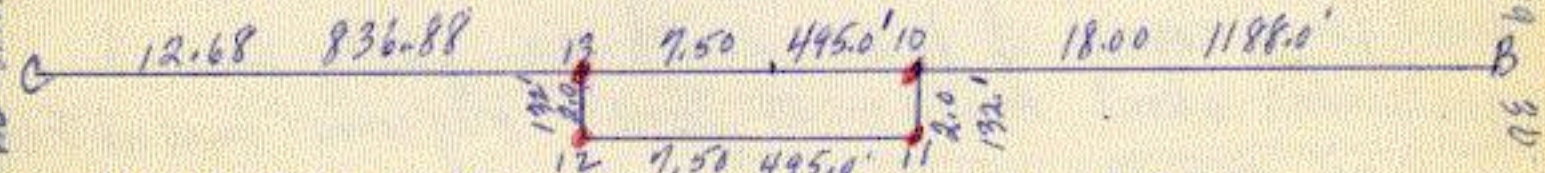

10 - planted stone 18 chs west of B and on line B.C.
11 - drove stake 2 chs south of 10 at right angle to line BC.
12 - set iron stake at right angle to line BC and from 13 south.
13 - set drove iron stake 1" about 5 foot long on line between B & C and
25.50 chs - 1683' west of B.

Card #2

#731904

1/4 Corner 19-30 Haverhill 107-13

Dec 1900 W. Fraser field Book 9 p. 83-88

found stake under NE edge of a Boxelder Tree on line of fence going North and where I kept it in place of an old stake that I found there in 1895 drove new stake, we went N. to ∫ (Cor. 19) and Measured South to "B" found Meas. 39.70.

3-1-77 Searched for Will Fraser's property corners set in Survey # 616. (~~Took line from NW 30 to NE 30~~ See Drug 3-40)

Card #1

at 10: dug into backhoe to bedrock 6" deep. Found nothing.

at 12: dipped for iron. Found nothing.

at 13: corner came on W. edge of road. Dipped but found nothing.

at 11: did not search for this corner

3-22-77 Set a C.I.M (down 12") over a railroad Spike driven in bedrock as the corner in cultivated field at Will Frasier measure from W. Sec. Cor 19-30 (Survey No 616) and 12 lks. North of the line between the Section corners as initiated by Will Frasier measurement to the E-W 1/4 line in Section 19 in Surveys #616 and 588

R.P.'s CSD N. side of S. gate post WNW 26.30'
CSD N. side of N. gate post NW 34.20
Spike and CSD W. side of 5" Twin Box Elder 3' E of the N-S fence SW 43.32
Corner approx 26' E of N-S fence.

1/4 CORNER 19-30 Haverhill 107-13 #3

7-6-89 MON. missing from road const. in '87 #731904
Set C.I.C./p² in median of C.R. 22 from reference ~~4~~s & distances from control pts. & previously set R/W monuments. set sign & post E 1.0' North
The corner falls in curve of C.R. 22 137.0' N of ℄ access drive So & 41.38' E of ℄ crack of concrete
C.R. 22 Tie to P.T. Control is 297.33'
Tie to M- is 262.13'

Cor Mets W.B. Yerby 1953 West Random 19+36

#731904

(4)

10.00 Set in temp Steel post

East on true line between Sta 19+30

W 89°44' East

38.98 Set in Steel post

Bur Oak 10 in N 70 E 74 lks

Bur Oak 10 in S 75 E 174 lks