8-29-1961. set C/M as corner. J Mann NE Cor #723805 (1)

section corner west 30-31 Haverhill 107-13
east 25-36 Cascade 107-14

10-1874 Hunter P 300 No 295 S 25 R Smith, H. Messinger
found org stake in mound at fence corner,
set stone in its place No mear.

9-1891 Thos Fraser P 456 No 440 S 30 John Holo.
found stone set by Hunter on east city limits
- Mear east P 457 32.16½ to corner set post.

12-3-1900 H Fraser P 700 No 616 S 30 E½ S 25
found stone north side of corner post. Leo Weber.
-16 west found Hunters unrecorded stake - set new stake
and small stone. - west 19.98.


- over -

16 North. set stake M & L 19.76 1/4.

June 1856 Thos Hunter A.S. No 14 Shows Sec corner
Mes South to 1/4 Post 39.98 chs.

corner stone found and used many years.
8-1961. set C/M while on John Miner job.
Corner lies on sharp N to S slope next to state lands & track.
1.0' west of N-S fence at junction of old fence west.
N E corner Jack Miner's sub-division

1863 P.C. Compton used the corner to set the 1/16th N (M&L)
1/16th W (M&L) and the 1/16th East (property lines dist.)
1/16th N Big tree: N 20° W 32 lks.
BK. A P. 69

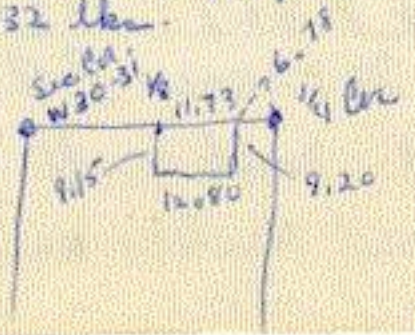

Section Corner West 30-31 Haverhill 107-13 (2)
East 25-36 Cascade 107-14

July, 1859 T. Hunter Pg 62 No 88 shows see Cor
1/16 North 19.52 chs. M&L to 1/4 Post. #733005
1/16 west 19.97 chs. M&L to 1/4 Post.
(See Survey for breakdown of S.E 1/4 Sec 25 107-14).

Corner Notes,
[illegible]
Section 25-30-31-36. [illegible]
[illegible]

11-19-84, W. Sec Cor. 30-31: Found CIM OK but area changed with Oak Cliff plat SW'ly. Drive survey marker sign and post. 8 West RP: CSD on N side power pole WSW 4.47