X 11-10-97 Set C/M over and drilled on Top engraved
10/29/85 set 1" sq pipe / cap in ~~Pavement~~ blacktop (1)
section corner township corner
SW 31 Haverhill, SE Cascade, NE Rochester, NW Marion
36 1 6

#733105

5-1891 Thos Fraser P 457 No 441 S 31 Stab & Minn
found engraved monument set by Hunter.
- Meas east 38.56½ then 39.86 to SE 31
2545.29 2630.76

6-1896 Hunter Deputy, P603 No 548 S 6 N Hulbert J. Coe
N Breckenridge.
found 8x8x30 engraved monument.
- Meas east 38.56 then 39.86 To NE 6.
2544.96 2630.76

7-1979 Shot CTM in Control Survey (Remon. Bk. Page 102)

- over -

corner found, steel rod riser above stone.
Dec 48" elm NE 75.8, 3/4" rod S 59.0.
corner in blacktop busy road, always working on it.

11-10-72. used air hammer. placed C/M directly on top of engraved monument making top of C/M flush with surface of new road complete.
- line directly west of large channel iron post set in concrete center median 10.0'
Meas electronic east to County point & S 31-32 C/M in rod surface. ~~5122.49~~ R 5176.05
2546.33 To S 31
2633.17 To S. 31-32
5179.50
Meas to point S 31 on direct line & wrnd angle from County Nail. ~~2548.68~~ R. 2545.29
Came. Then ~~2623.81~~ R.2630.76 to S 31-32. 2546.33 - 1978 Co Surv
Then 2633.17 Co Surv. elec.

#733105 (2)

Section Corner Township Corner

SW 31 Haverhill, SE 36 Cascade, NE 1 Rochester, NW 6 Manor

3/11/1980 Took additional reference to CIM before sewer construction.

- Punch cross in SE corner of light base WNW 83.63
- C.S.D. in N. side power pole WSW 124.05
- Spike and C.S.D. in scar on N. side 16" pine SW 101.65


1980 - Removed CIM and cut stone monument (to office) when sewer went through.

9-8-81 Set C.I.M. flush w/ bit surface over a 5/8 rod Took No additional R.P.'s

Gore Hwy

75+ ft [illegible]

6-3-85, SW Cr 31: Took R.P's before construction. Removed CIM. Set ½" re-rod for temp. point.

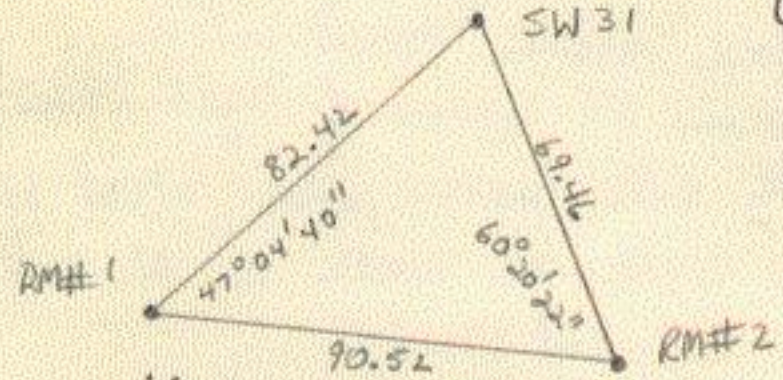

RM#1: PK nail in saw joint in concrete median 1.0 S'ly of back of N'ly curb and 18.68 SW'ly of back of curb at Eastly end of median (at saw joint).

RM#2: PK nail in saw joint in concrete curb, 1.2 N'ly of back of curb and 8.62 W'ly of top center of hydrant.

#733105

(3)

SW Cor 31, Haverhill Twp

10-24-85, SW 31: Set 1" sq. pipe/cap in new b.t. from RP's taken 6-3-85. Corner 7.2 West of line of center of concrete median running North on 19th St SE and 20.2 South of back of curb at South end of median (21.3 SSW of back of curb at center South end of median).